


T.3S., R.38&39E., W.M.

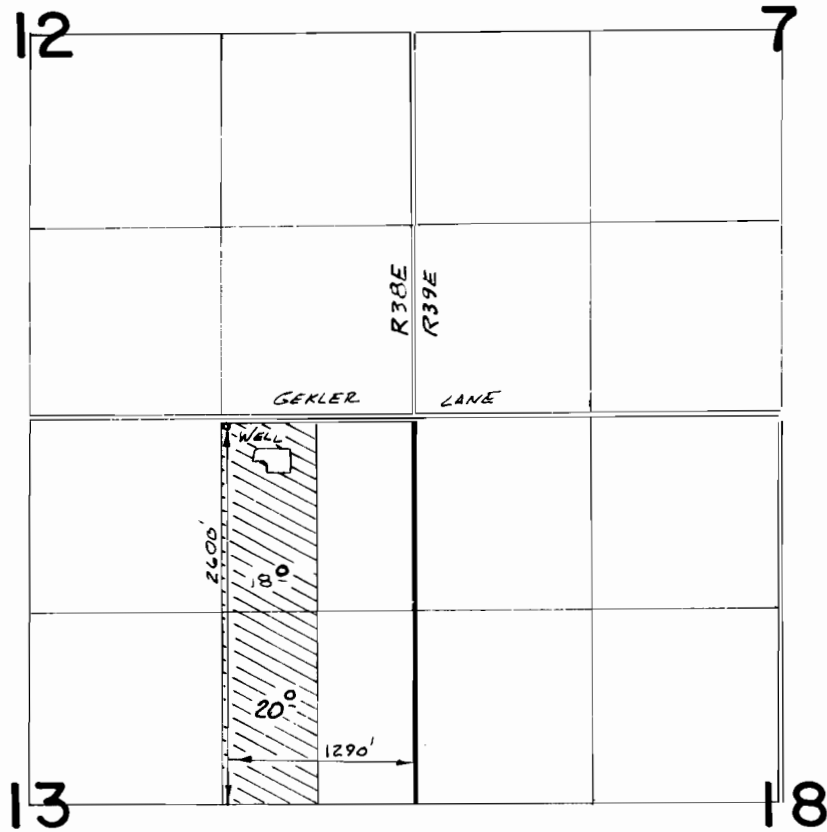

FINAL PROOF SURVEY
UNDER

Application No. **G:9460** Permit No. **G:8906**
IN NAME OF

WALTER P. HANSEN

Surveyed *Nov. 17*, 19*81*, by *V. H. Church*