


T. 3S., R. 1W., W.M.

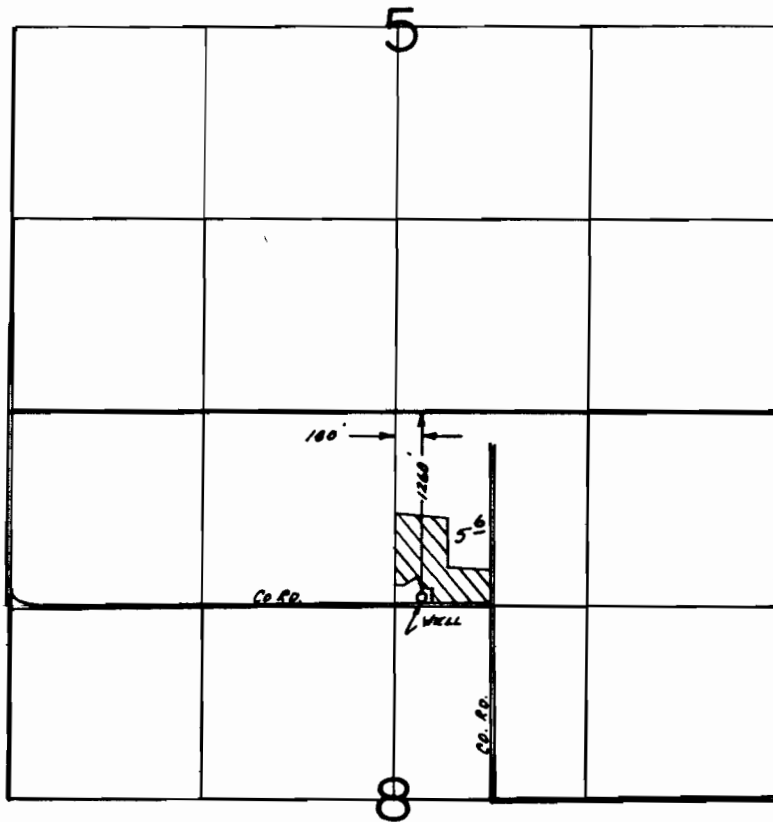

SCALE: 1" = 1320'

FINAL PROOF SURVEY
UNDER

Application No. G-9559.. Permit No. G-8944.....
IN NAME OF

.....ALLAN L. ROGERS.....

Surveyed Aug. 14... 1984, by J.R. WOODROOF.