


T.10S.,R.2W.,W.M.

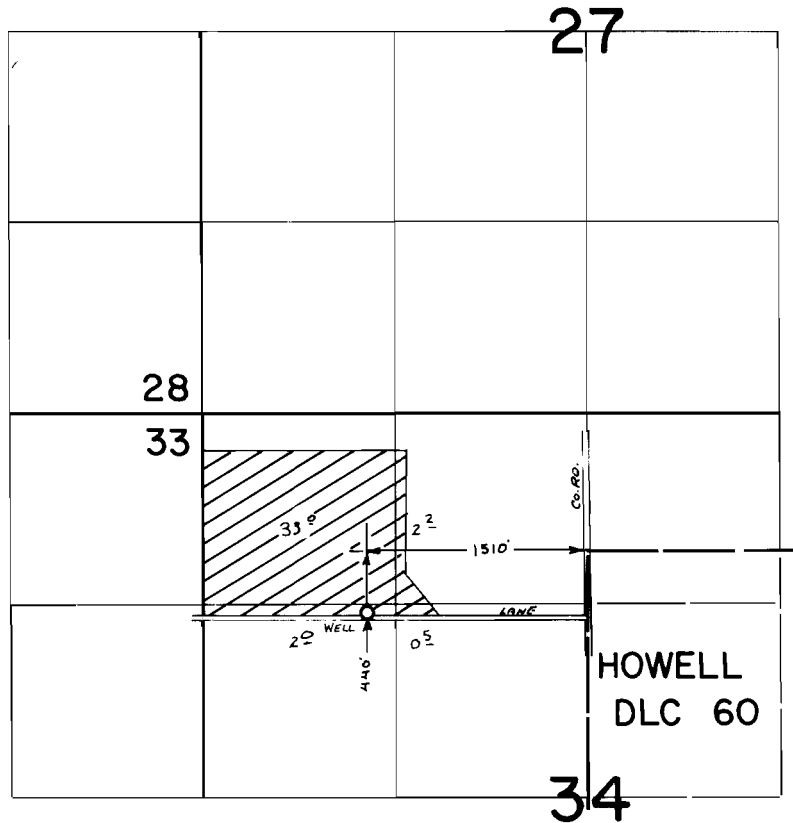

FINAL PROOF SURVEY UNDER

Application No. G-9593 Permit No. G-8946
IN NAME OF

STANLEY MCGILL

Surveyed July 2, 1992, by L.M. TOLL