


T.5S.,R.2W.,W.M.

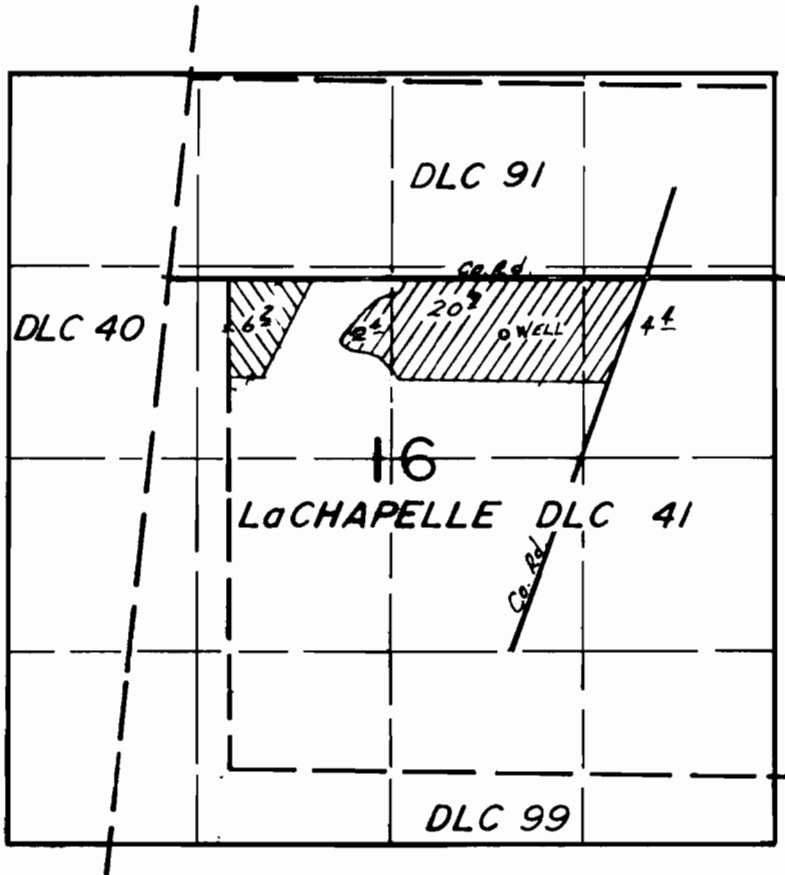

WELL LOC: 360'S. & 1880'E FROM NW COR. LACHAPELLE DLC 41

FINAL PROOF SURVEY
UNDER

G-9891 G-8928
Application No. G-10898 Permit No. G-10042
IN NAME OF

..... RICHARD D. WOLF

Surveyed OCT. 3, 1983, by L.M.T.O.L.L.....