

RECEIVED

MAR 11 1983


WATER RESOURCES DEPT.  
SALEM, OREGON

T.4N. R.1&2W. W.M.

RECEIVED

SEP 22 1981

WATER RESOURCES DEPT.  
SALEM, OREGON

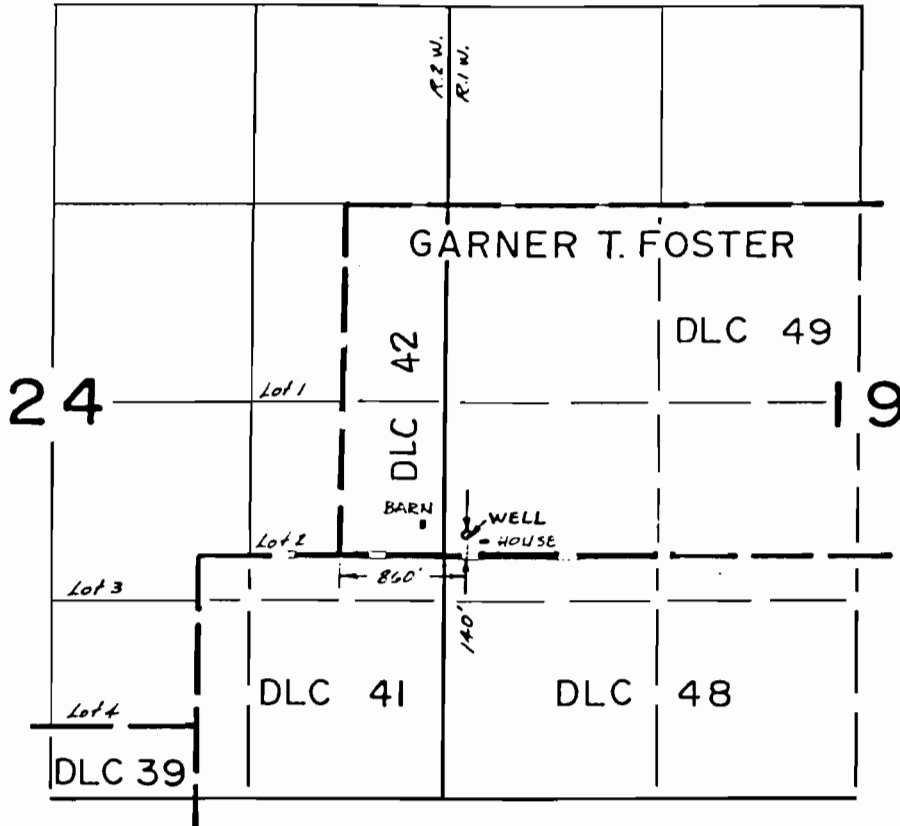

FINAL PROOF SURVEY Application No. G-9928  
 UNDER Permit No. G10128

~~Application No. G-3797 Permit No. G-3777~~

IN NAME OF

~~PAUL T. CORIN~~

Surveyed JUNE 11, 1975, by R.G. MUCKEN