


# T. 1S. R. 4E. W. M.

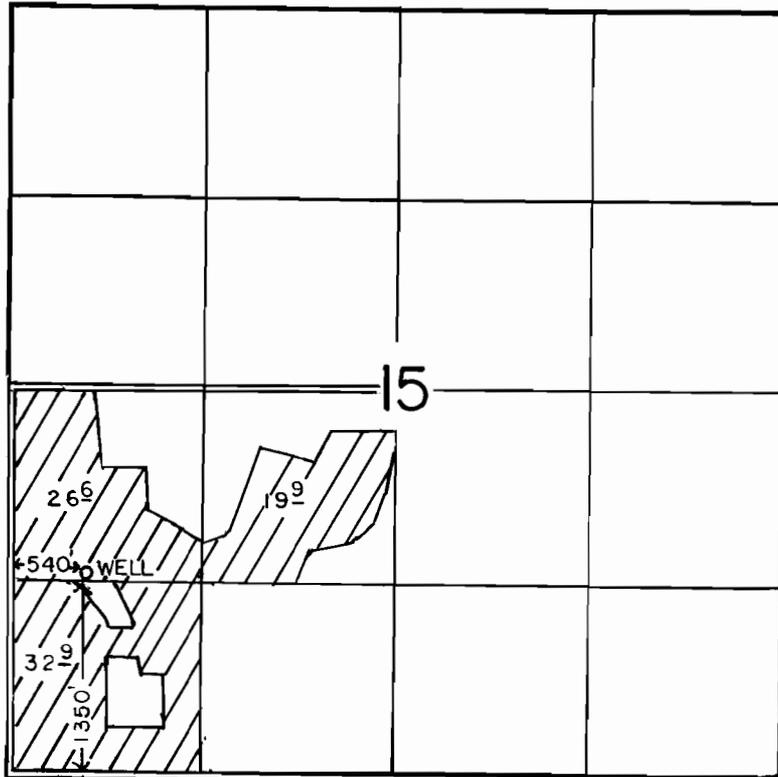

SCALE: 1" = 1320'

## FINAL PROOF SURVEY UNDER

Application No. G-9940.. Permit No. G-9005.....  
IN NAME OF

GARY MELVIN MOLLER

Surveyed MAY..12... 1987., by T.M. WARREN.....