


T.1S. R.3E. W.M.

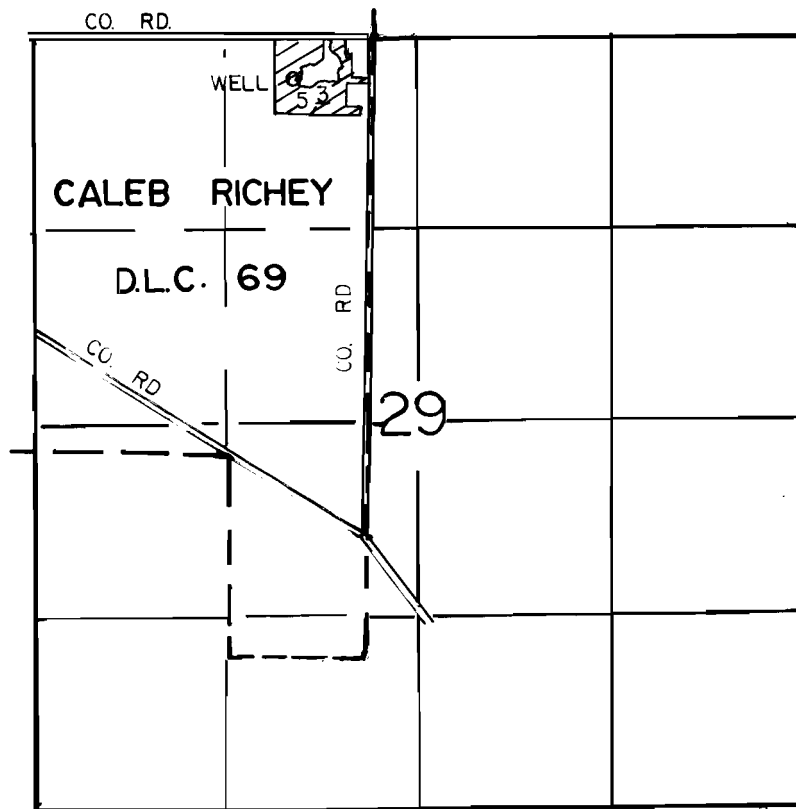

WELL LOC. 300' S. & 950' W. FROM THE N.1/4 COR. OF SEC. 29

SCALE: 1" = 1320'

FINAL PROOF SURVEY UNDER

Application No. G-10663 Permit No. G-9583
IN NAME OF

KENNETH SPIESS

Surveyed SEPT. 8, 1987, by J.M. WARREN