


G-9790
60743

T39S. R.19E. W.M.

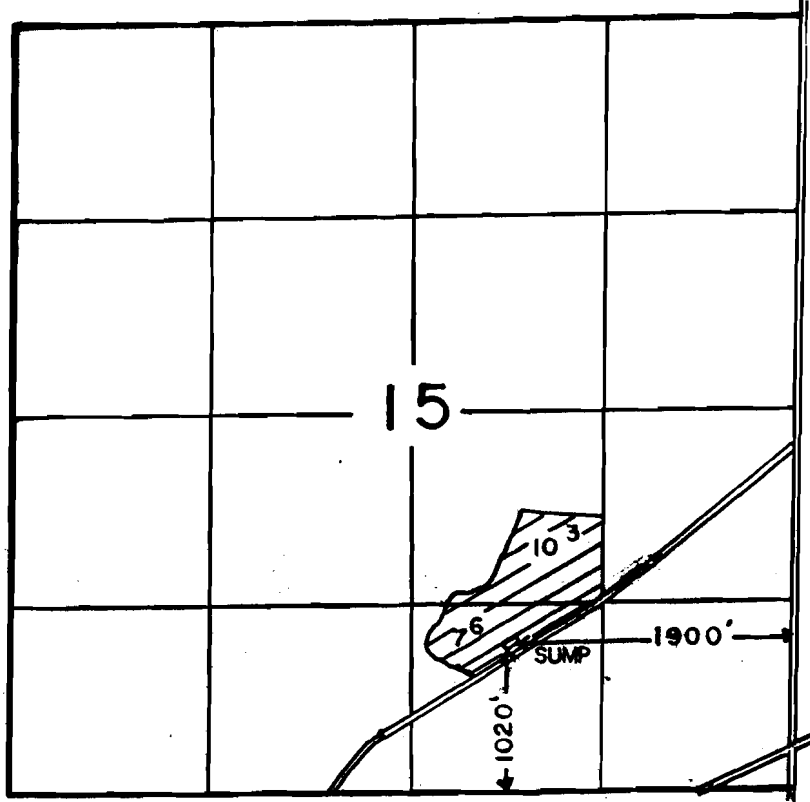

SCALE: 1" = 1320'

FINAL PROOF SURVEY UNDER

Application No. G-10707. Permit No. G-9790.....
IN NAME OF

.....DENNIS R. GLENDER.....

Surveyed ...OCT. 15. 1987., by M.J. MAITICK.....