


T. 23S., R. 27E., W. M.

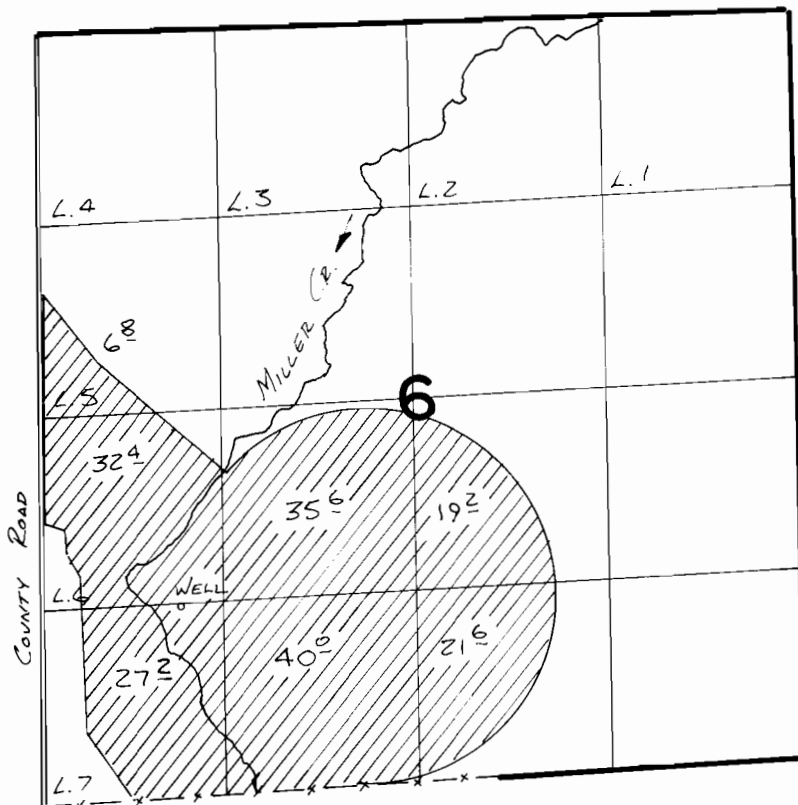

SCALE 1" = 1320'

WELL Loc: 1310' N. & 950' E FROM SW. COR. SEC. 6

FINAL PROOF SURVEY
UNDER

Application No. **G:11114** Permit No. **G:10246**
IN NAME OF

CHARLES F. MACOMBER

Surveyed 5-7-1988, by V.L. Church