


T.12 S., R. 5 W., W.M.

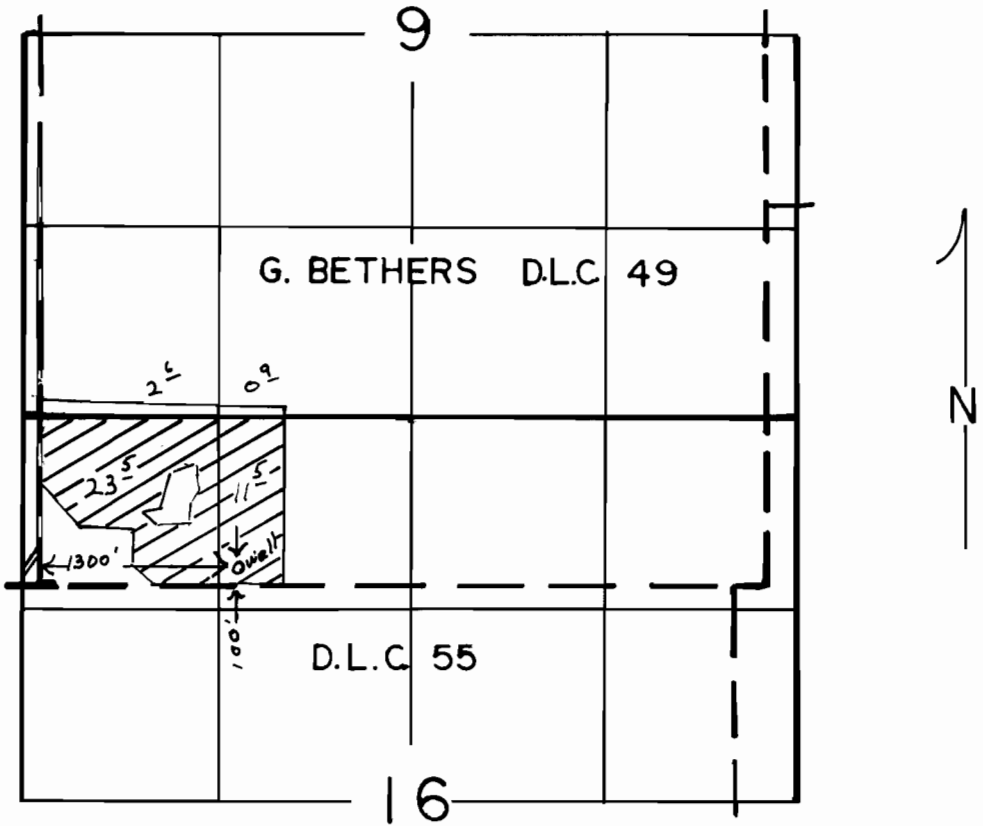

SCALE: 1" = 1320'

FINAL PROOF SURVEY UNDER

Application No. G-11330 Permit No. G-10457.
IN NAME OF

.....STANLEY L. STARR.....

Surveyed OCT. 7..... 1987., by T.M. WARREN.....