


T.39S. R.14W. W.M.

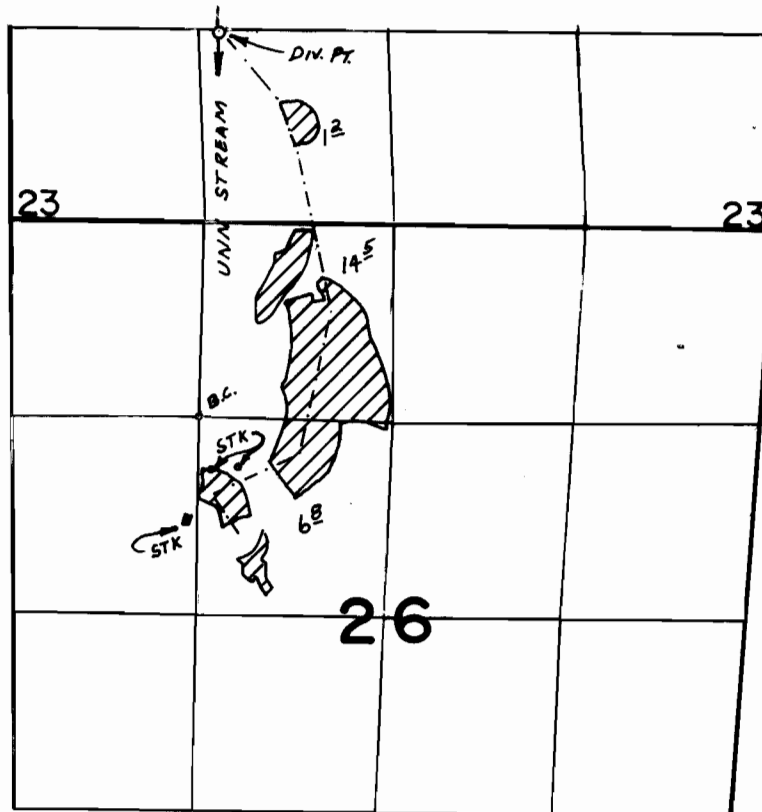

DIV. PT. LOC. 2640' N & 140' E. FROM CENTER NW 1/4 SEC. 26.

FINAL PROOF SURVEY
UNDER

Application No. 46971 Permit No. 35145
IN NAME OF

MICHAEL FITZGERALD

Surveyed AUG. 30. 1976, by L.H. NUNN