


T4N, R9W, WM

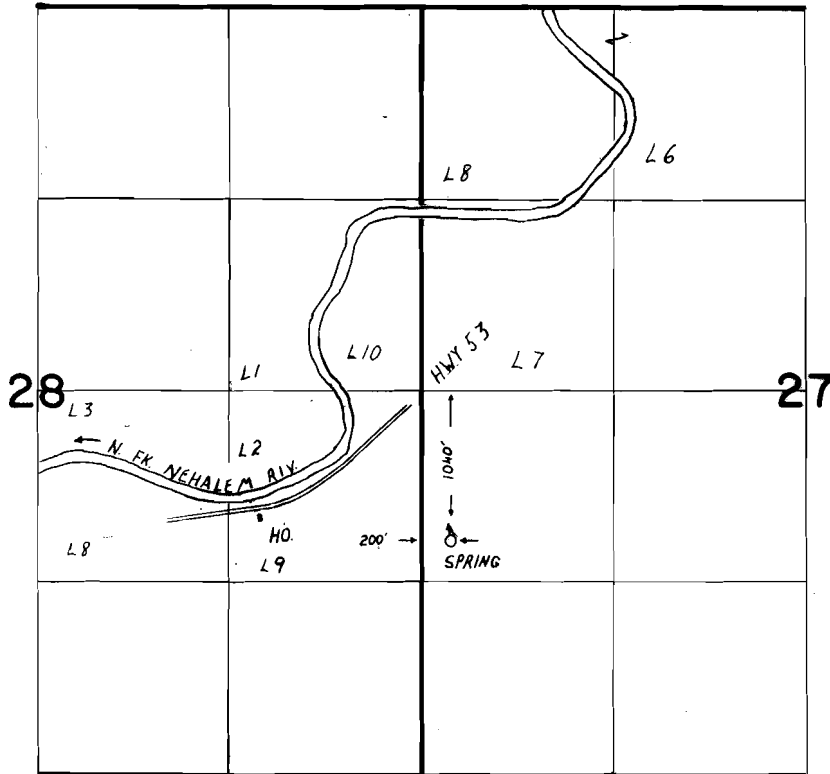

FINAL PROOF SURVEY UNDER

Application No. 53771.. Permit No. 40379.....
IN NAME OF

..... LOUISE OWEN

Surveyed AUG. 17... 1988, by T.M. WARREN.....