


T. 3S. R.1E. W.M.

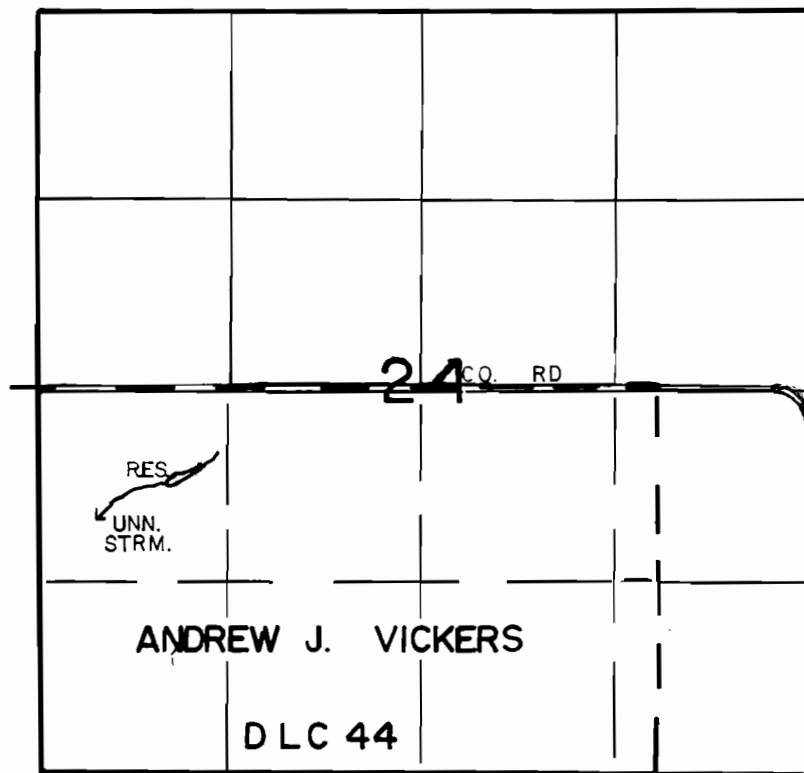

DIV. PT. LOC. 2000' N. AND 850' E. FROM. THE S.W. COR. SEC. 24

FINAL PROOF SURVEY

UNDER

R-54823

R- 6548

Application No. ~~54824~~ Permit No. ~~41086~~....

IN NAME OF

.....JAMES.....GARVER.....

Surveyed AUG 4..... 19.87., by T.M. WARREN.....