




T.27S., R.12&13 W., W.M.

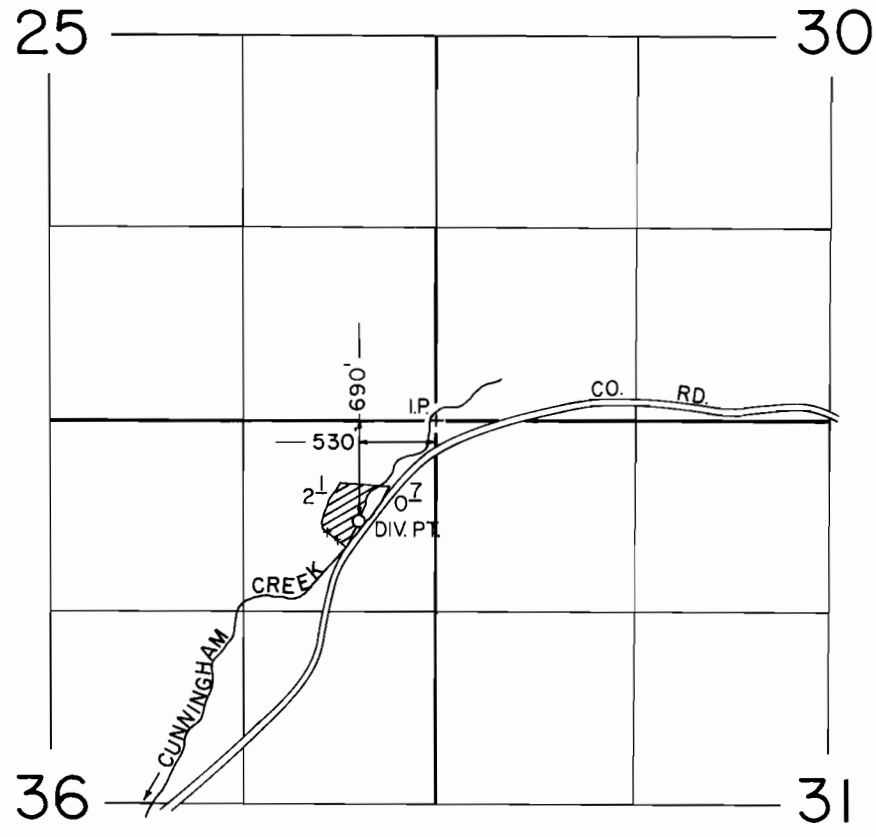

SCALE: 1" = 1320'

**FINAL PROOF SURVEY**  
UNDER

Application No. 54938 Permit No. 41204  
IN NAME OF

GLADE M. & BETTY KREWSON

Surveyed SEPT. 20 1988, by B. S. JAMES