


# T9N, R7W, WM SEC 35 & 36

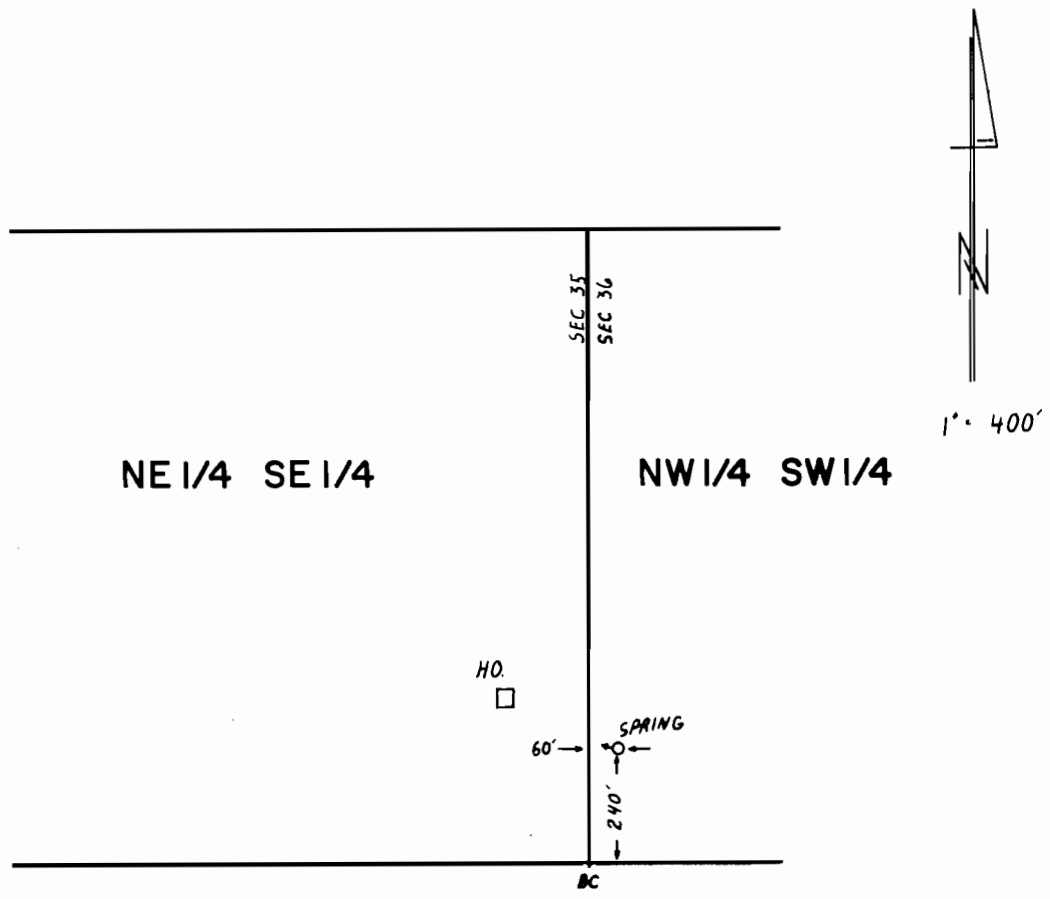

## FINAL PROOF SURVEY UNDER

Application No. 55054 Permit No. 41378...  
IN NAME OF

.....EDWARD J. JOHNSON.....

Surveyed JULY 20 1988, by J.M. WARREN...