


T. 3S R. 3E. W.M.

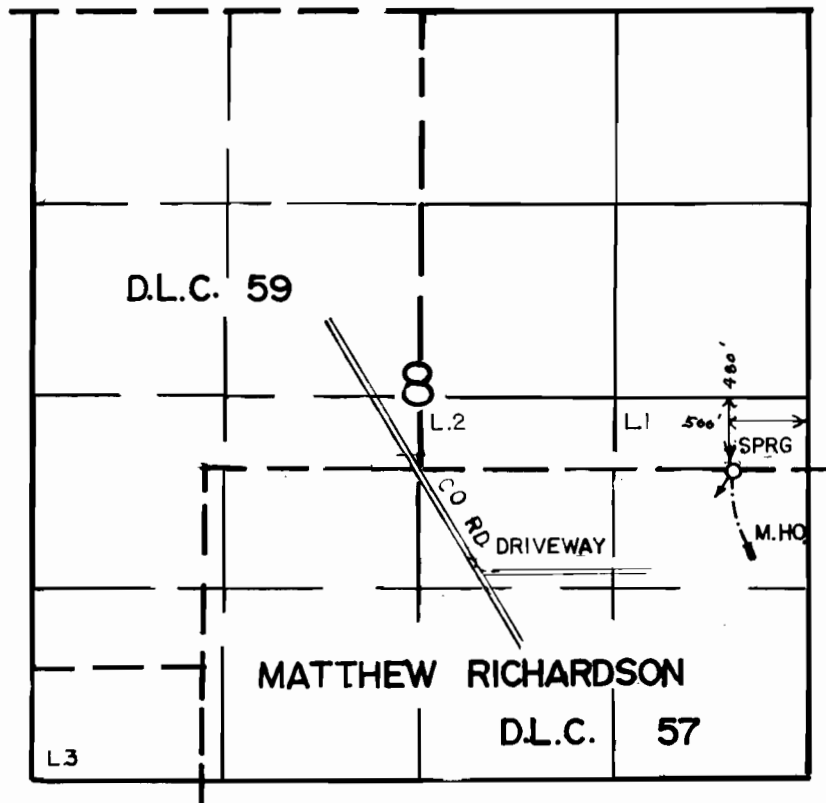

SCALE: 1" = 1320'

# FINAL PROOF SURVEY

UNDER

Application No. **55164**... Permit No. **41348**....  
IN NAME OF

.....**FLORENCE**.....**LANGE**.....

Surveyed **AUG. 7**..... 1987..., by **J.M. WARREN**.....