


T.2S. R.6E. W.M.

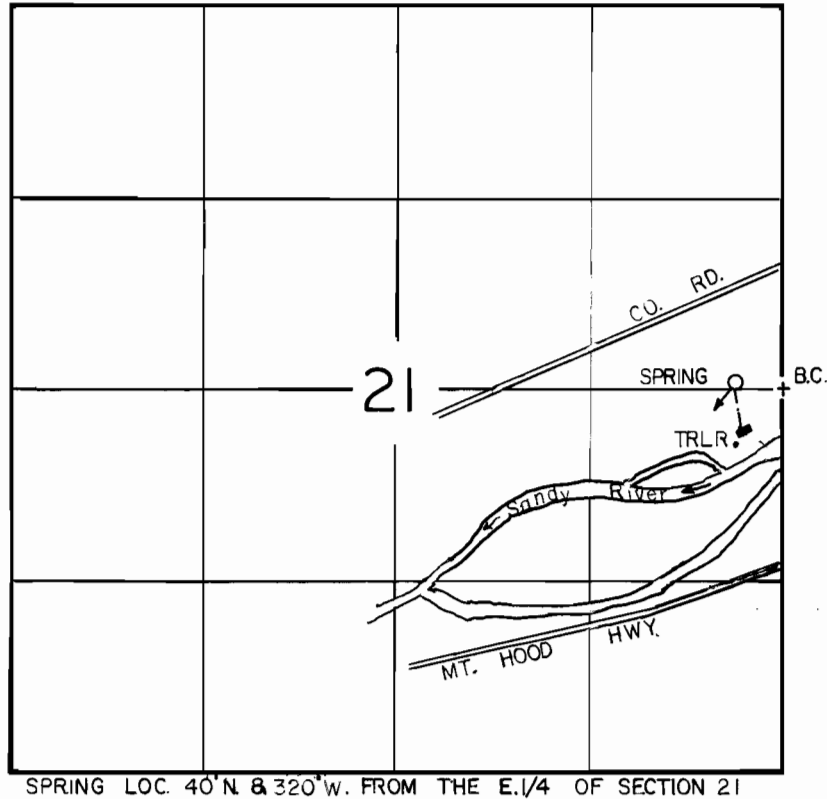

SCALE: 1" = 1320'

FINAL PROOF SURVEY

UNDER

Application No. 55538. Permit No. 41853.....
IN NAME OF

RALPH C. ASLA

Surveyed AUG. 28. 1987., by T.M. WARREN.....