


T.11S., R.40E., W.M.

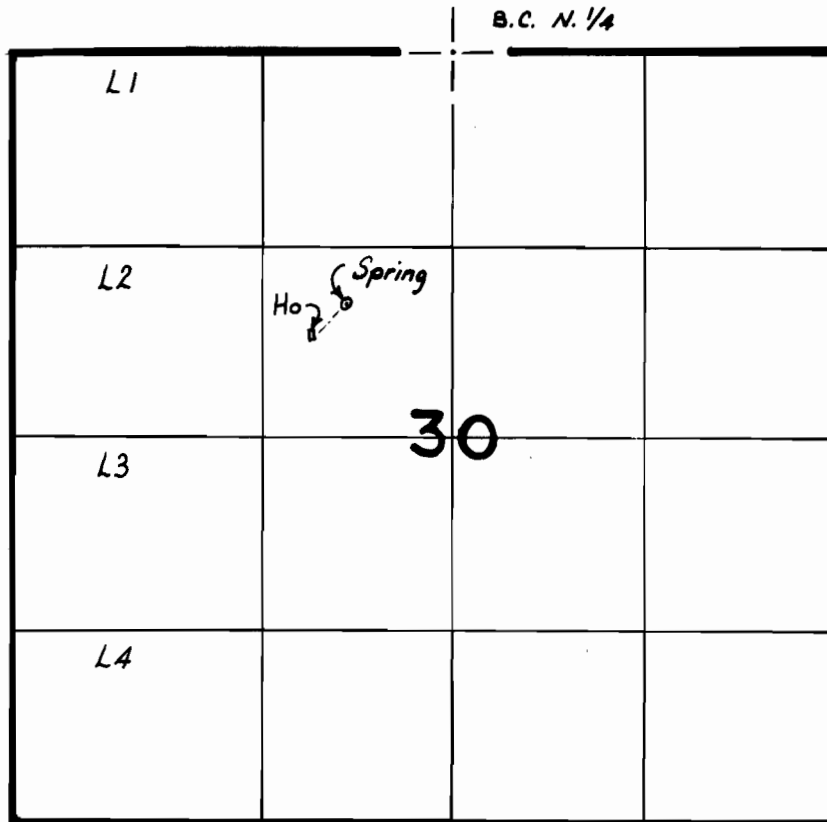

The location of the spring is 1720' S. & 720' W. from N 1/4 cor. sec. 30.

FINAL PROOF SURVEY
UNDER

Scale: 1" = 1320'

Application No. 55982 Permit No. 42125
IN NAME OF

ELMER SHUFF & LILLIAN SHUFF

Surveyed 8-23 1988, by Vern Church

P.T.S. KK