WATER RIGHTS SURVEY

LOCATED IN THE SOUTHEAST QUARTER
OF SECTION 32, TOWNSHIP 24 SOUTH,
RANGE 11 WEST, W.M.,
COOS COUNTY, OREGON

SCALE: 1" = 100' DATE: MAY 1, 1977

FOR: ELWIN SALING
BOX 512 COOS RIVER ROUTE
COOS BAY, OREGON 97420

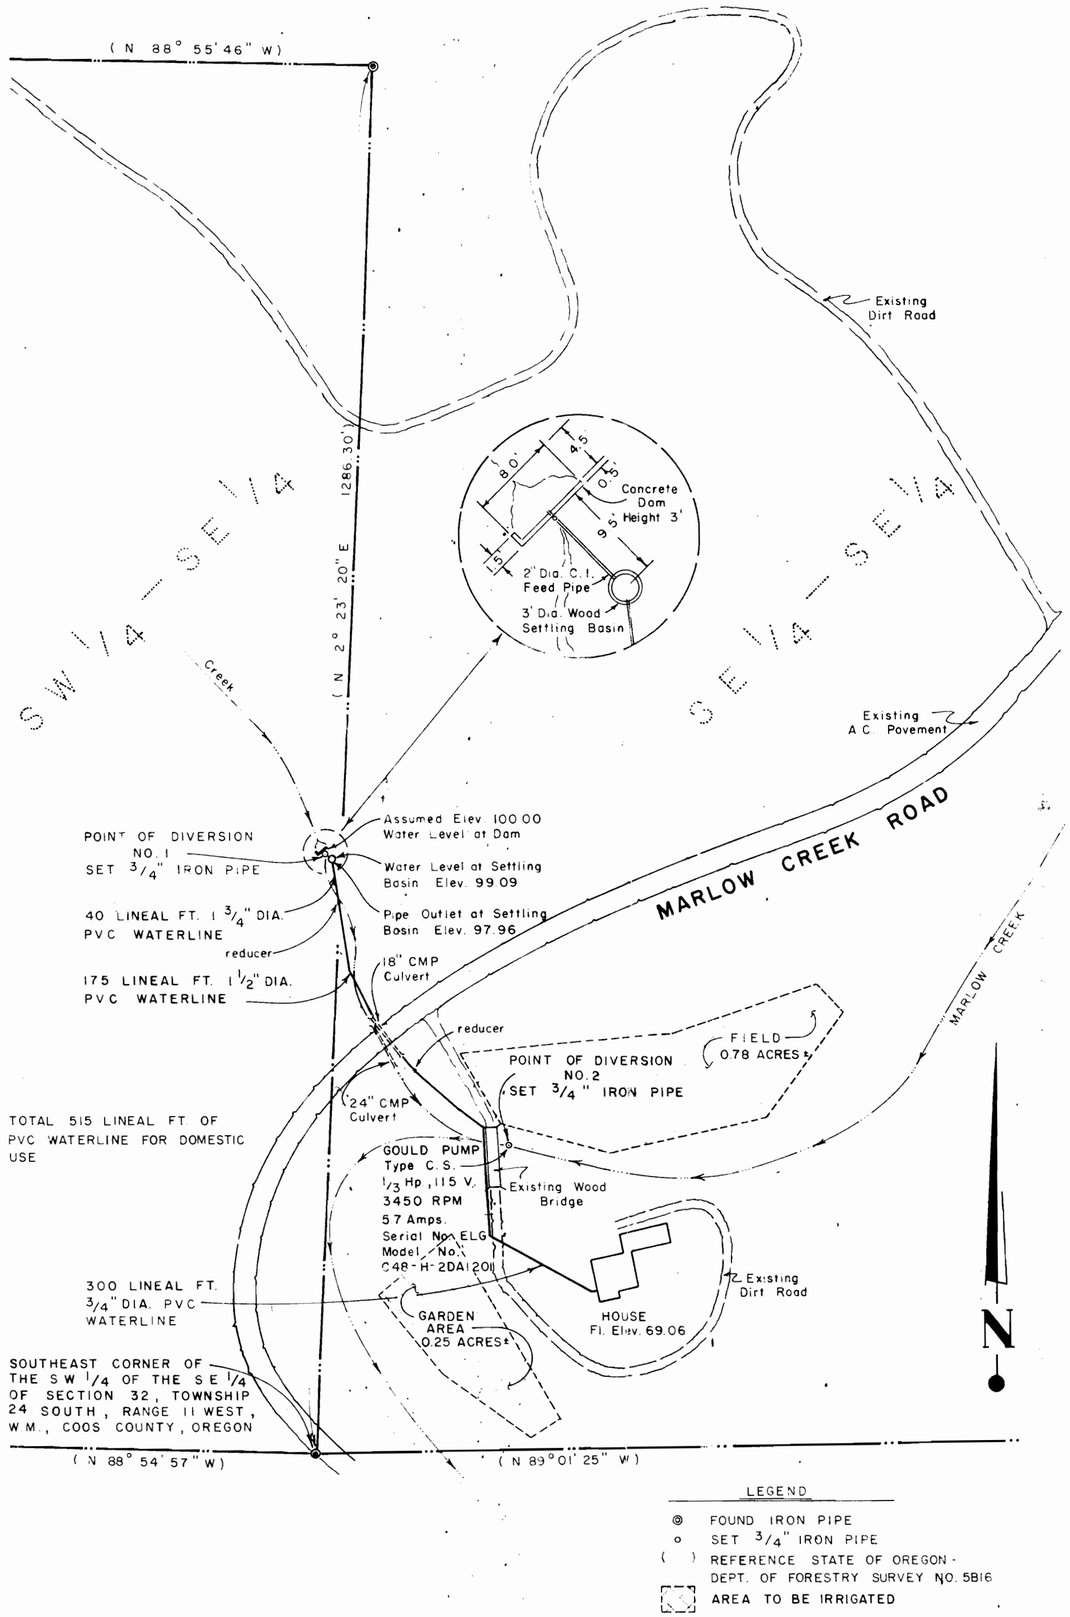

LOCATION OF POINTS OF DIVERSION

TIES FROM THE SOUTHEAST CORNER OF THE SOUTHWEST QUARTER OF THE SOUTHEAST QUARTER OF SECTION 32, TOWNSHIP 24 SOUTH, RANGE 11 WEST, W.M., COOS COUNTY, OREGON.

1.) POINT OF DIVERSION NO. 1 (DOMESTIC SUPPLY)
N 1° 01' 34" E 557.40 FT.

2.) POINT OF DIVERSION NO. 2 (IRRIGATION SUPPLY)
N 32° 14' 47" E 336.90 FT.

NOTE: BEARINGS BASED ON SOLAR OBSERVATIONS OF FEBRUARY 3, 1977.

REGISTERED PROFESSIONAL LAND SURVEYOR
OREGON
OCTOBER 4, 1957
ROBERT W. WADE
433

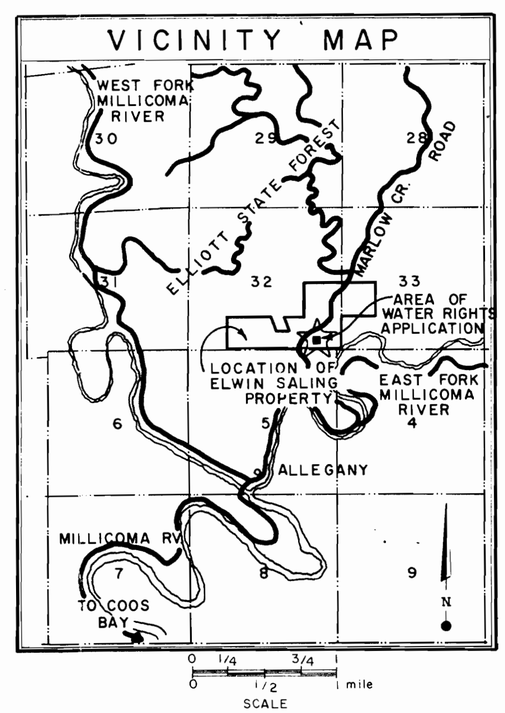

LEGEND

- ◎ FOUND IRON PIPE
- ○ SET 3/4" IRON PIPE
- ( ) REFERENCE STATE OF OREGON - DEPT. OF FORESTRY SURVEY NO. 5816
- AREA TO BE IRRIGATED

Application No. 6
Permit No. 42085 42084

5TH AND HIGHLAND
COOS BAY, OREGON
269-1166
ENGINEERS • PLANNERS
HGE INC