


# T. 28S., R. 6W., W.M.

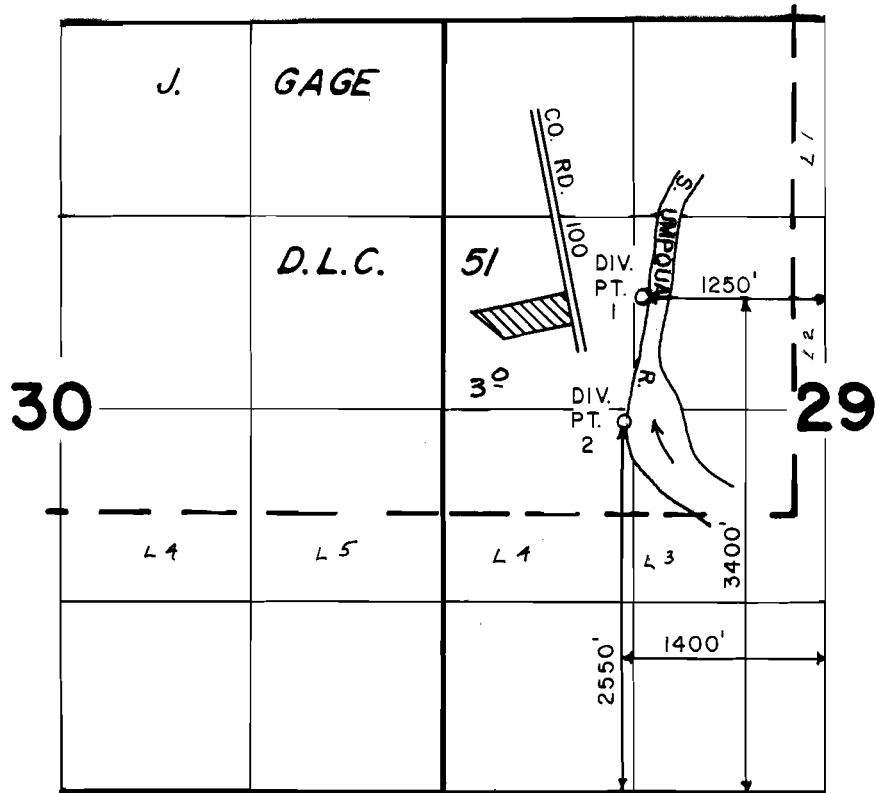

SCALE: 4" = 1 MILE

## FINAL PROOF SURVEY UNDER

Application No. 56151 Permit No. 42290  
IN NAME OF

**JOHN B. WHITE**

Surveyed SEPT. 27 1984, by L. E. CASHION.