


T. 2N., R. 40E., W. M.

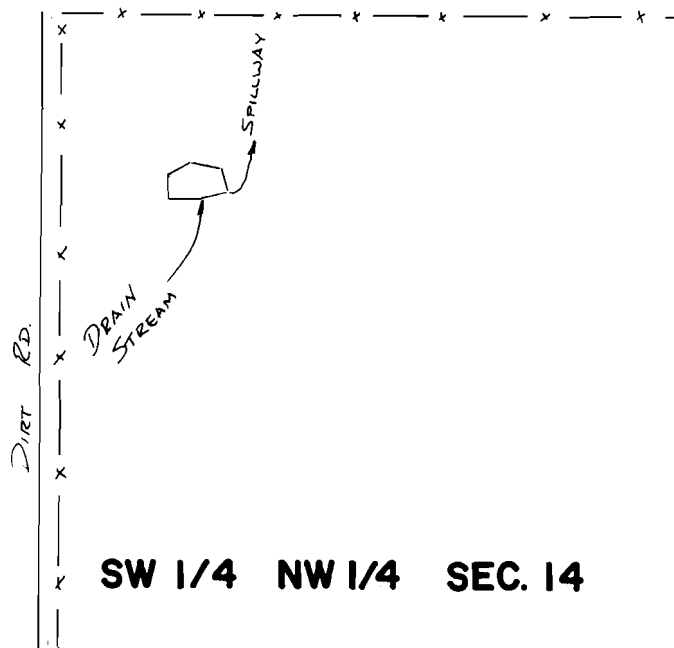

SCALE 1" = 400'

FINAL PROOF SURVEY
UNDER

Application No. **R-56527** Permit No. **R-6678**
IN NAME OF

JOSEPH WHEELER

Surveyed 11-2 1987, by V.L. Church