


90884

T. 22 S., R. 4 W., W. M.

SECTION 31

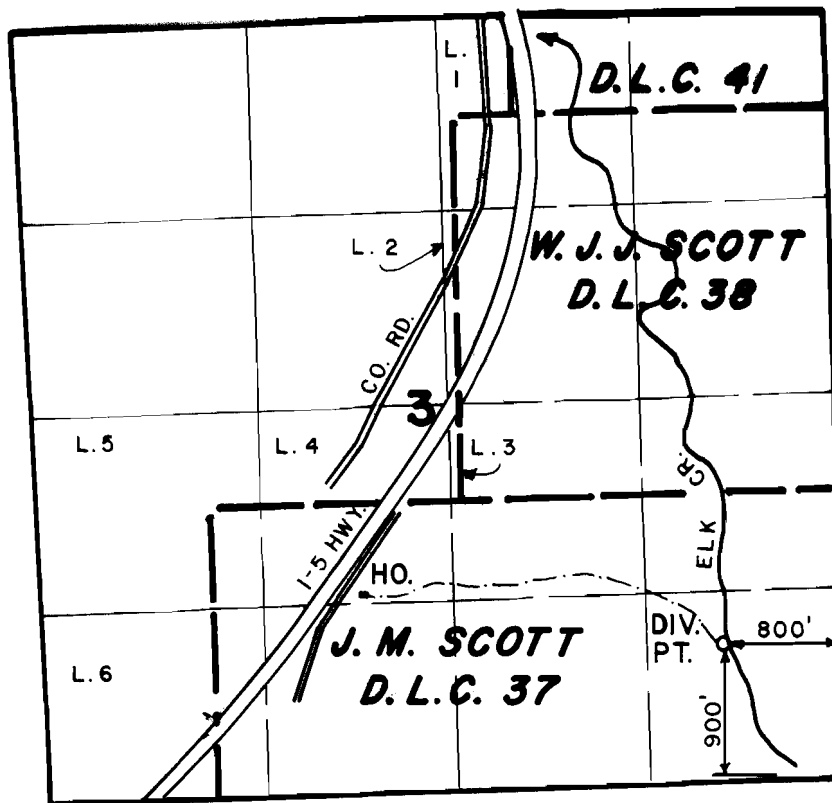

SCALE: 4" = 1 MILE

FINAL PROOF SURVEY
UNDER

TRANSFER NUMBER 3831
Application No. 56779.. Permit No. 42583.....
IN NAME OF

DAN R. RUSSELL

Surveyed AUG. 11.... 1988., by J. M. SCHMORDE