




T. 28 S., R. 11 W., W.M.

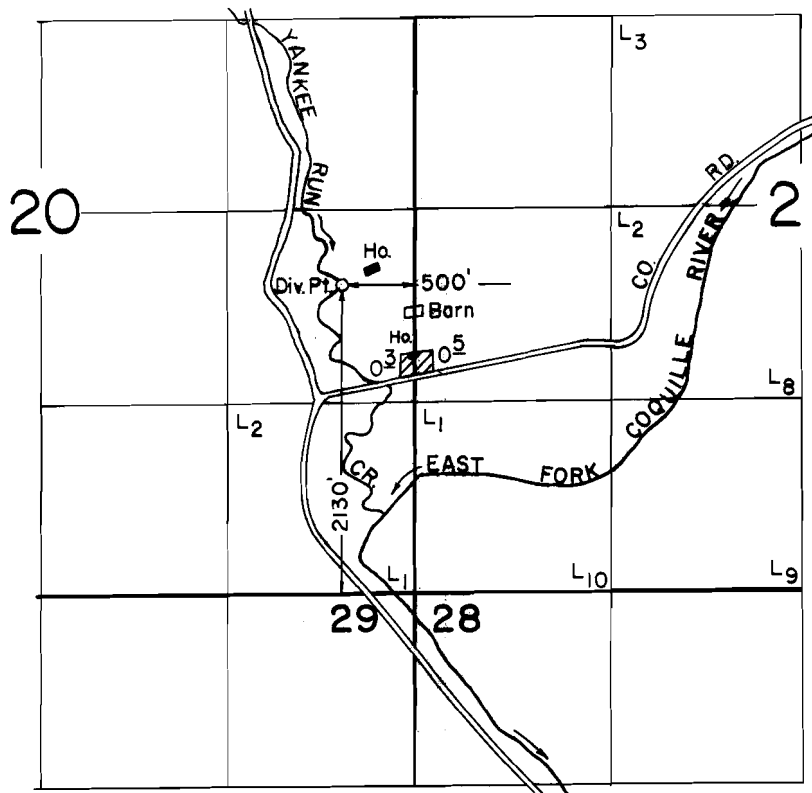

SCALE: 1" = 1320'

**FINAL PROOF SURVEY**  
UNDER

Application No. 56821... Permit No. 42826.....  
IN NAME OF

R. M. & B. P. HERMES

Surveyed SEPT. 19 1988, by K. KEMP.....