


T. 38 S., R. 8 W., W.M.

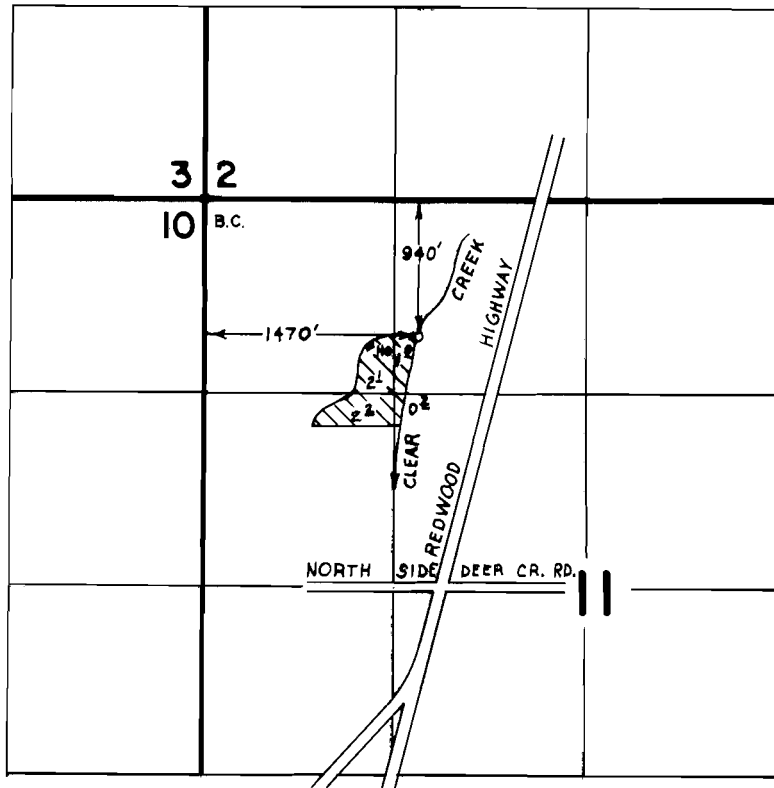

FINAL PROOF SURVEY
UNDER

Application No. **56838** Permit No. **42736**
IN NAME OF

EUGENE L. VANDERMARK

Surveyed **OCT. 26**, 19**83**, by **B. S. JAMES**

SCALE: 4" = 1 MILE