


T. 2 N., R. 4 W., W.M.

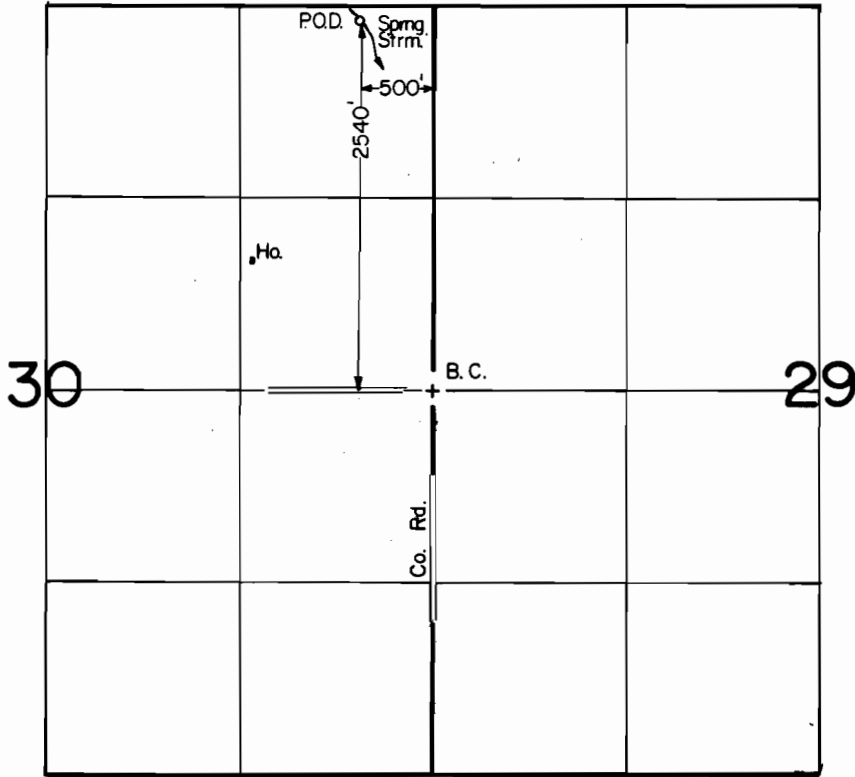

Scale : 1" = 1320'

FINAL PROOF SURVEY UNDER

Application No. 56853. Permit No. 42918.....

IN NAME OF

DARRELL L. & RAE L. JONES

Surveyed AUG. 8 1988, by T. Warren.....