


# T4N, R9W, WM

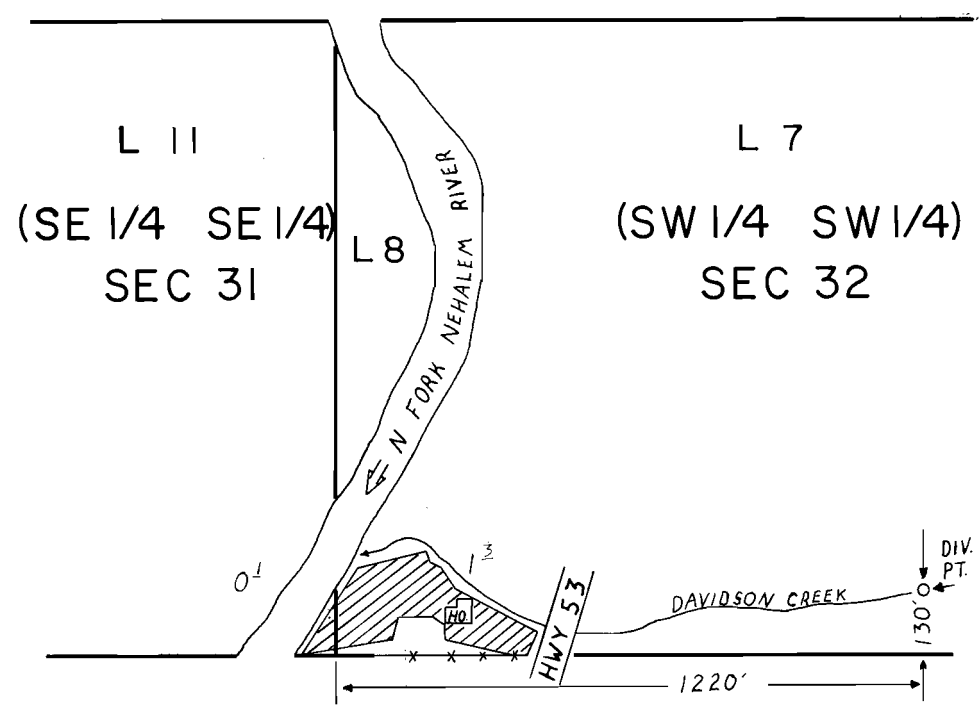

## FINAL PROOF SURVEY UNDER

Application No. ..57.111.. Permit No. ..43.129.....  
IN NAME OF

...JAMES R. & LORETTA ERICKSON

Surveyed AUG. 15, 1988, by R.W. KLASSEN

RWK  
PTS. W/EE