


T.3S., R.2W., W.M.

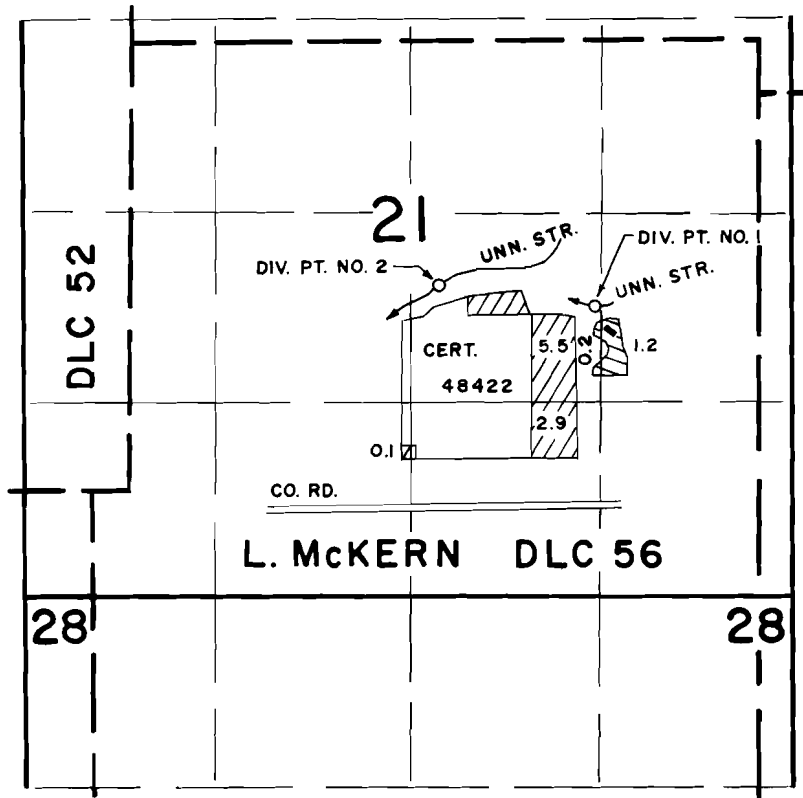

PERMIT 43247
PERMIT 44409

DIV. PT. NO. 1 LOC.: 2000 FT. N. AND 1260 FT. E.;
DIV. PT. NO. 2 LOC.: 2140 FT. N. AND 180 FT. E.;
BOTH FROM THE S. 1/4 CORNER OF SECTION 21.



FINAL PROOF SURVEY
UNDER

SCALE: 4" = 1 MILE

57384 43247
Application No. 58941.. Permit No. 44409....
IN NAME OF

CRAIG EAGLESON

Surveyed NOV. 13., 1984., by P. Paster