



T.8S., R.46E., W.M.

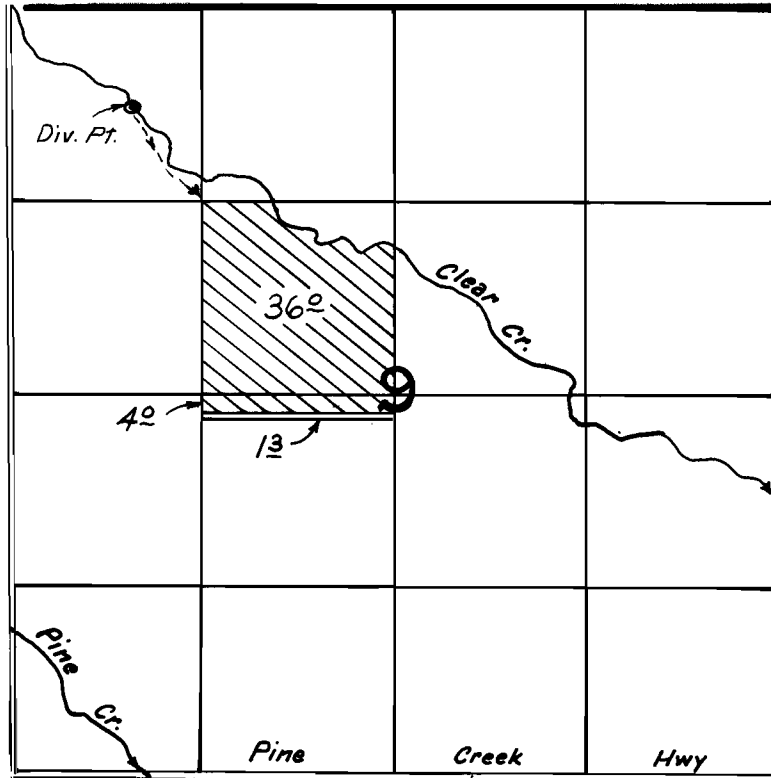

The location of the div. pt. is 670' S. & 850' E. from NE cor. sec. 9.

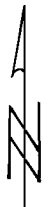

Scale: 1" = 1320'

FINAL PROOF SURVEY UNDER

Application No. 57444 Permit No. 43258
IN NAME OF

AARON INGALLS

Surveyed 8-3 1988, by Vern Church