


T. 3 S., R. 5 W. W.M.

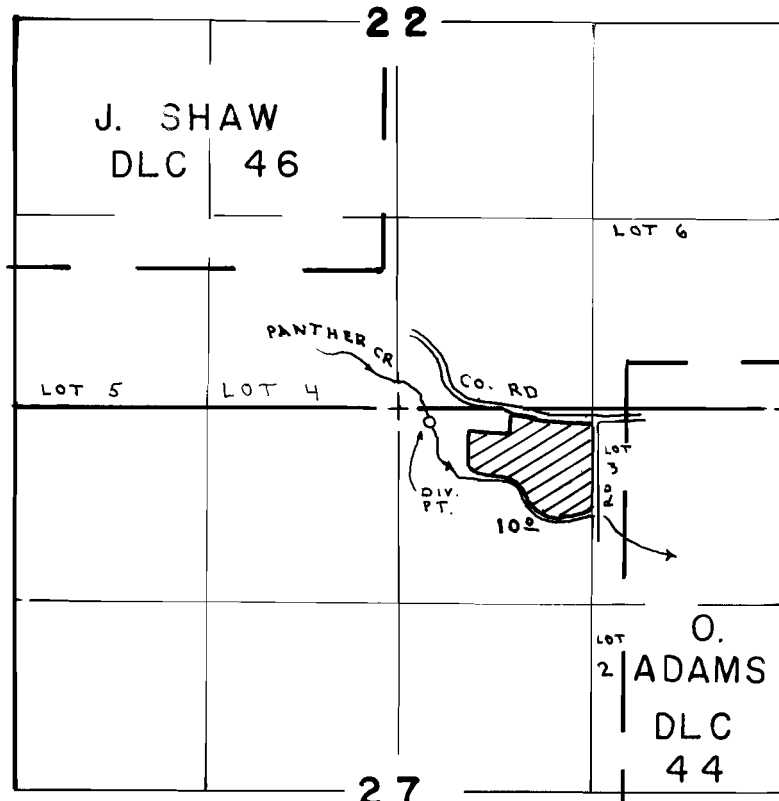

DIV. PT. LOC. 90' S. & 220' E. OF N. 1/4 COR. SEC. 27

N  
SCALE  
4" = 1 MILE

**FINAL PROOF SURVEY**  
UNDER

Application No. 57697. Permit No. 43444.....  
IN NAME OF

RONALD I. & GAYLE CHRISTENSEN

Surveyed JUL 11 1984, by P. THRELKELD.