


T.10S.,R.27E.,W.M.

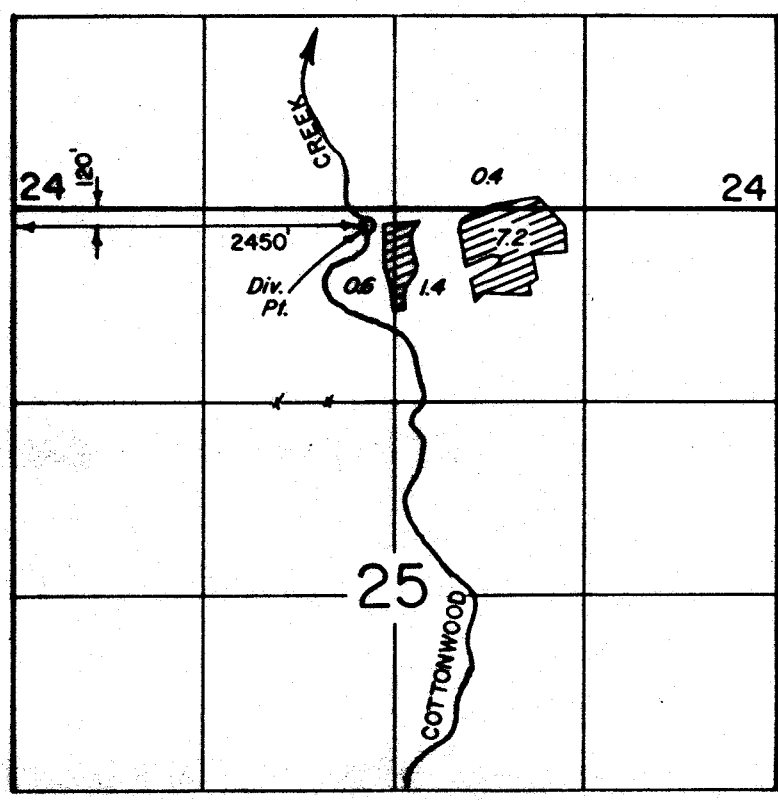

FINAL PROOF SURVEY UNDER

Application No. 57726 Permit No. 43455

IN NAME OF

CRYSTAL GIENGER

Surveyed OCT. 6, 1981, by W. Brown