


T. 37 S., R. 5 W., W. M.

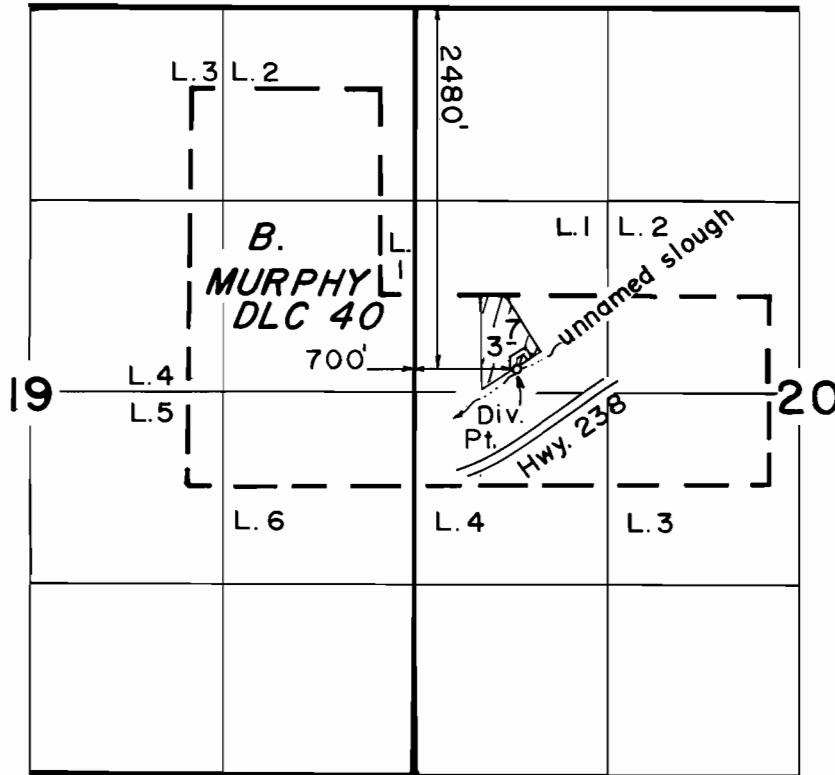

Scale: 1" = 1320'

FINAL PROOF SURVEY
UNDER

Application No. **57886** Permit No. **43588**...
IN NAME OF

.....*PAUL MOUNT*.....

Surveyed **MAY 14, 1986**, by **B. R. SUND**.....