


T 2S. R. 5E. W. M.

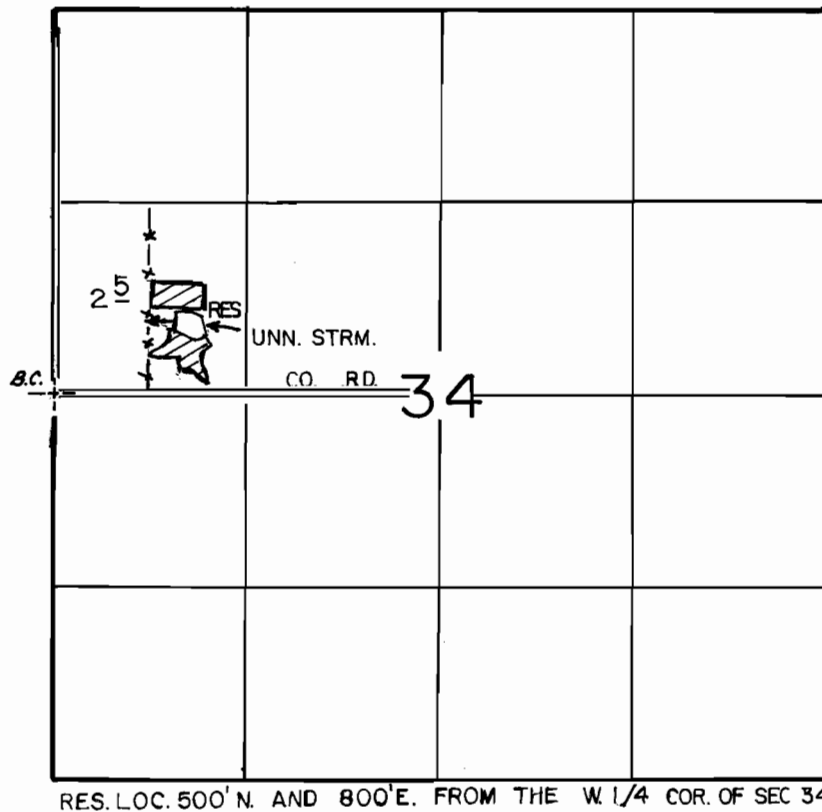

SCALE: 1" = 1320'

FINAL PROOF SURVEY

UNDER

R-579 II R-777 I
 Application No. 57912 Permit No. 43770
 IN NAME OF

THOMAS E. STEFFL

Surveyed JULY 29, 1987, by T. M. WARREN