


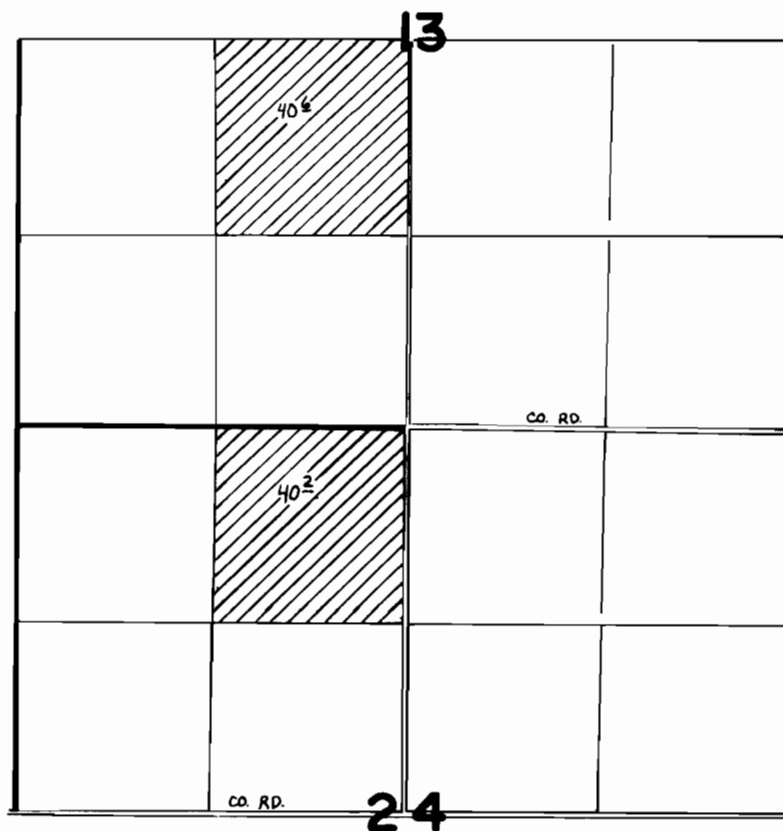

T.4 N. R. 34 E. W.M.

Scale 1" = 1320'



FINAL PROOF SURVEY
UNDER

Application No. 58082. Permit No. 43723.....
IN NAME OF

.....**JOHNS, SMITH, AND BEAMER**.....

Surveyed July 2, 1986, by J. Sauter.....

SE 1/4 Sec. 26, T.4 N.R.34 E.

