


T.27S.,R.7W.,W.M.

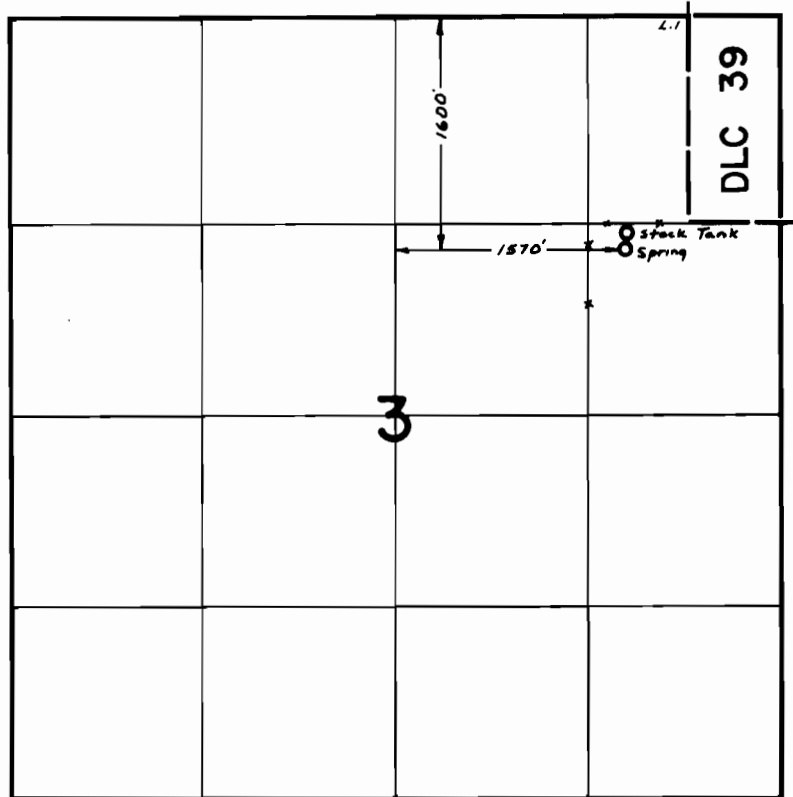

FINAL PROOF SURVEY UNDER

Application No. 58235 Permit No. 43900
IN NAME OF

ROY A. & MARILYN A. SJOGREN

Surveyed June 24 1982, by L. M. TOLL