


T. 3S. R. 4E. W.M.

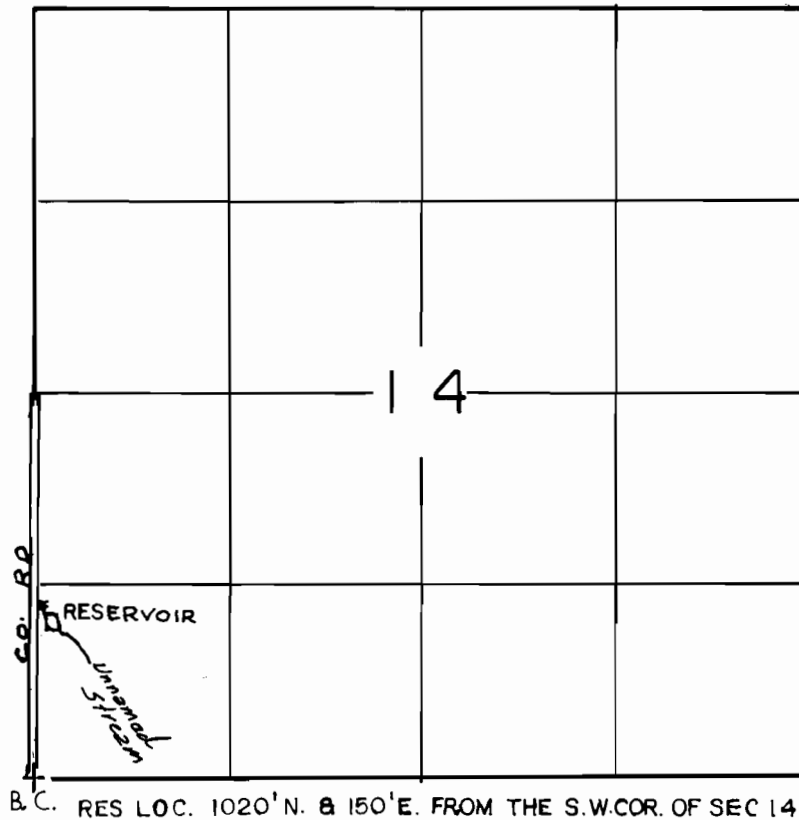

B.C. RES LOC. 1020' N. & 150' E. FROM THE S.W. COR. OF SEC 14

SCALE: 1" = 1320'

FINAL PROOF SURVEY

UNDER

Application No. R-59711 Permit No. R-8169
 IN NAME OF

MIKE C. & LINDA HALSETH

Surveyed AUG 26, 1987, by T.M. WARREN