


T.3 S. R.2 E. W.M.

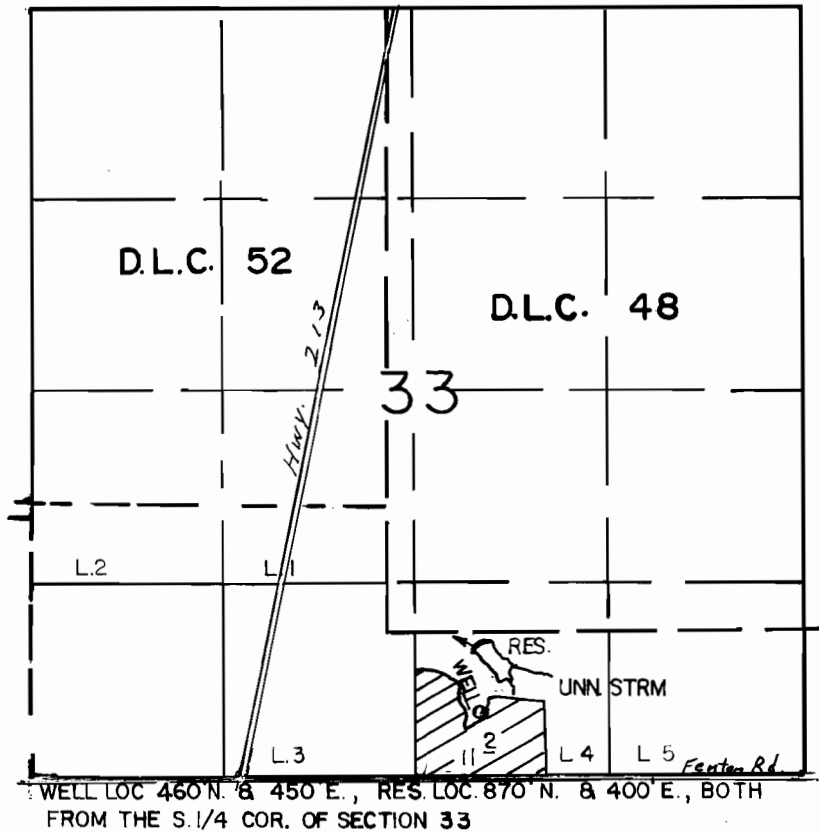

FINAL PROOF SURVEY

UNDER

R-59778
59779

R- 8195
45283

Application No. G-9542 Permit No. G-9037....
IN NAME OF

JAMES F. JUSTICE

Surveyed AUG. 6..... 1987..., by T.M. WARREN