
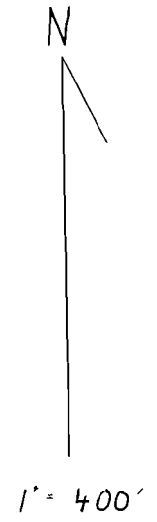


T. 8 S., R. 5 W., W.M.
NE 1/4 SW 1/4
SEC. 11

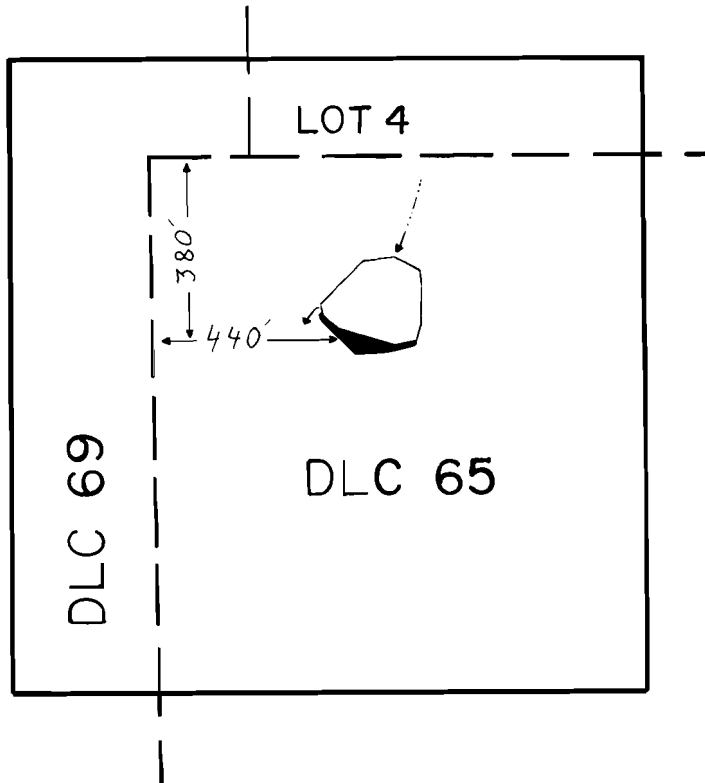

FINAL PROOF SURVEY
UNDER

R-60209 R-8240
Application No. ...60210... Permit No.45568....
IN NAME OF

.....ANN GARIGAN.....

Surveyed JUNE 8, 1987, by B.W. BISHOP.....