


\* 45126  
60798

# T. 34 S. R. 7E. WM.

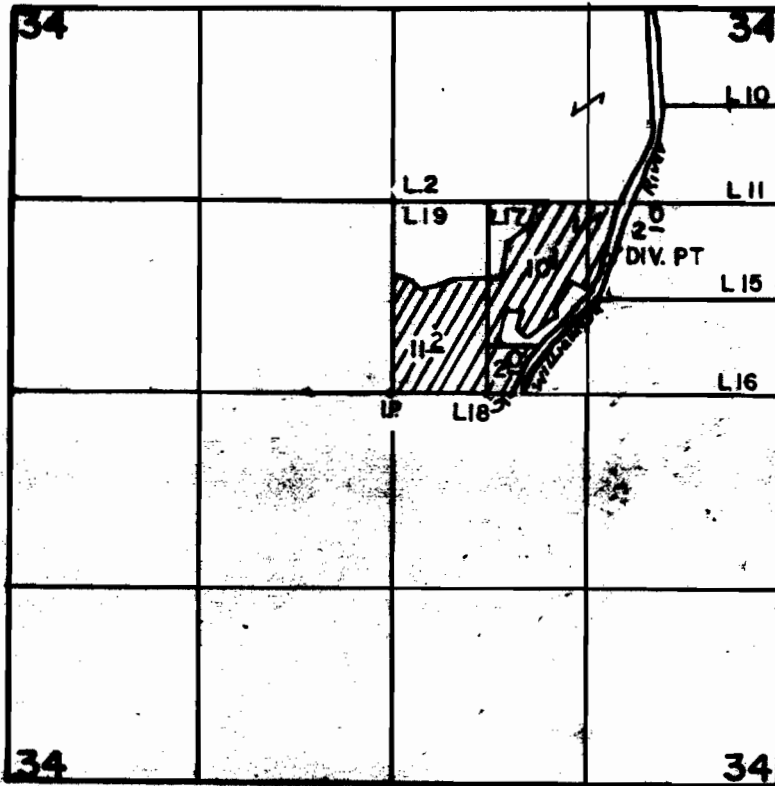

DIV. PT. LOC. 900' N. & 1200' W. FROM THE E1/4 COR. OF SEC. 34

SCALE: 1" = 1320'

## FINAL PROOF SURVEY UNDER

Application No. ~~60249~~ Permit No. 45126....  
IN NAME OF

...ROBERT M. & ALICE M. WAMPLER

Surveyed AUG. 20.... 1987., by T.M. WARREN.....