


# T.38 S., R.3 W., W.M.

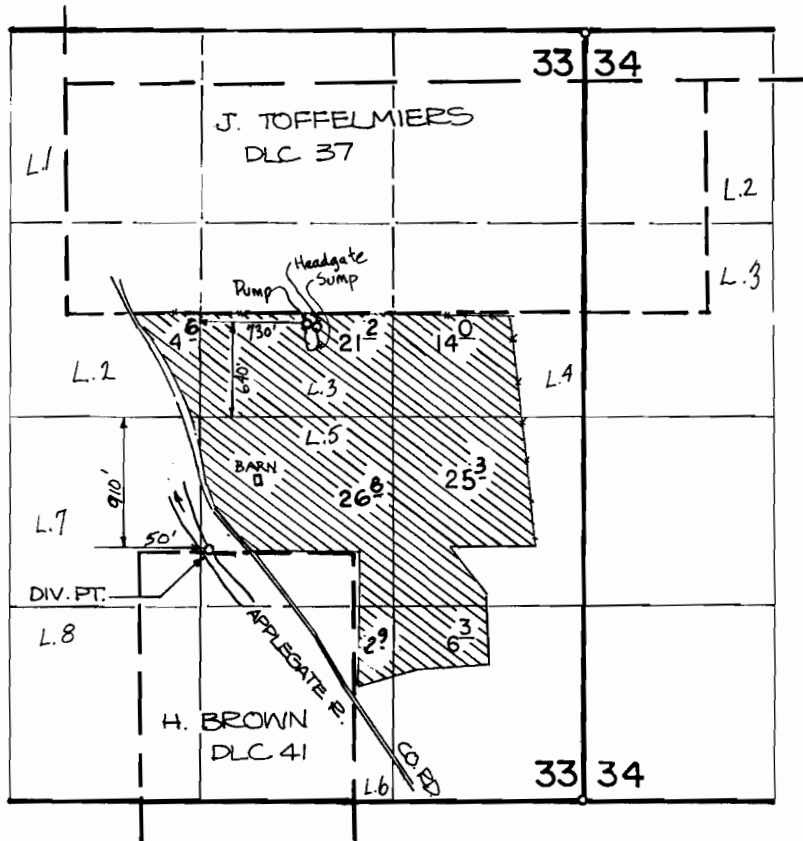

## FINAL PROOF SURVEY

UNDER

Application No. ~~G 8636~~ 62251 61179 ..... Permit No. ~~G 8003~~ 46141 45539 .....

IN NAME OF

**ELDA CRANE & WAYNE A. & LINDA HEALY**

Surveyed MAY 18, 1983, by B. S. JAMES .....