


T.24S., R.4W., W.M.

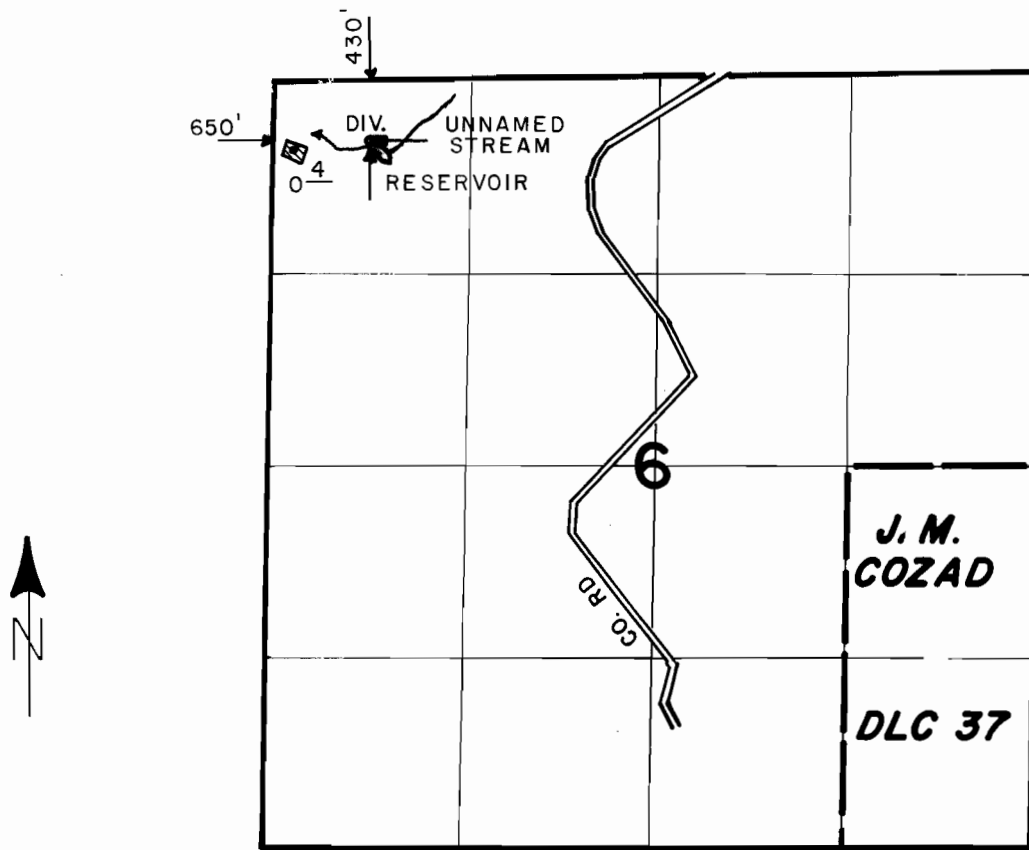

SCALE: 4" = 1 MILE

FINAL PROOF SURVEY
UNDER

R-61882 R-8440
Application No. 61883 Permit No. 46761
IN NAME OF

ARCHIE T. MC CULLOUGH

Surveyed AUG. 15, 1988, by J.M. SCHMORDE