


RECEIVED

JUL 13 1981

WATER RESOURCES DEPT
SALEM, OREGON

T. 24 S. R. 4 $\frac{1}{2}$ W. W.M.

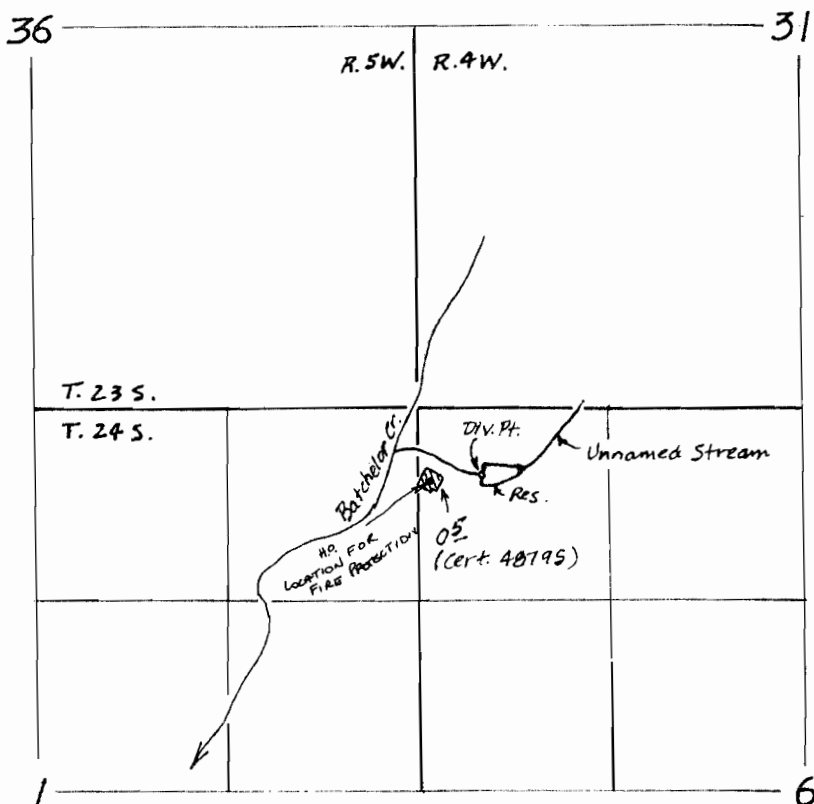

Scale: 4" = 1 mile

Div. Pt.: 460' S. and 2210' W. from N $\frac{1}{4}$ Cor. Sec. 6.

Application No. R-61882 &
61883
Permit No. R 8440

46761

RECEIVED

JUN 28 1982

WATER RESOURCES DEPT
SALEM, OREGON