




T.28S.,R.11W.,W.M.

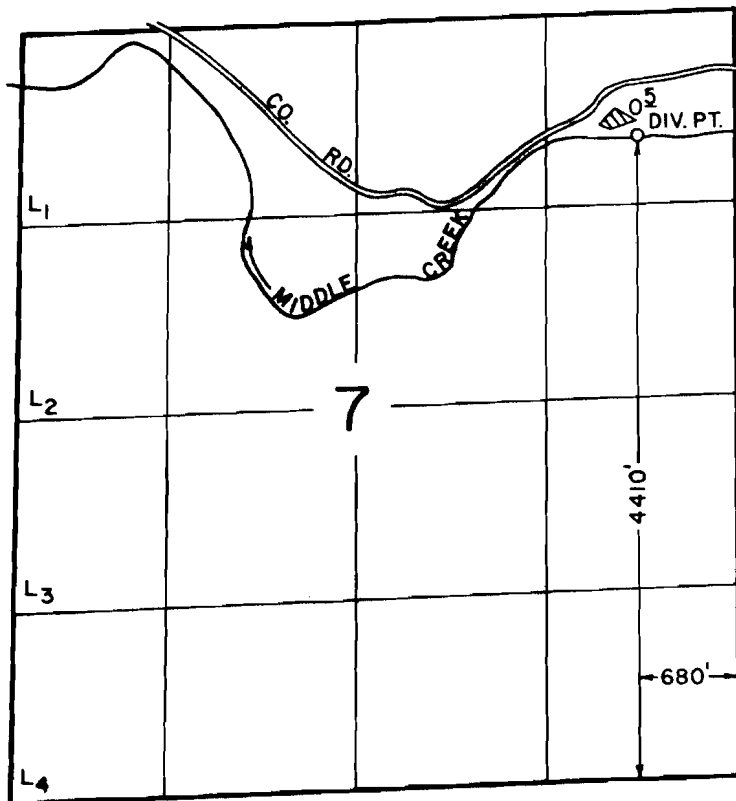

SCALE: 1" = 1320'

FINAL PROOF SURVEY
UNDER

Application No. 61965... Permit No. 46284...
IN NAME OF

..... THOMAS RAY TISSOT

Surveyed SEPT. 20 1988, by K.D. KEMP.....