


T.3S. R.1E. W.M.

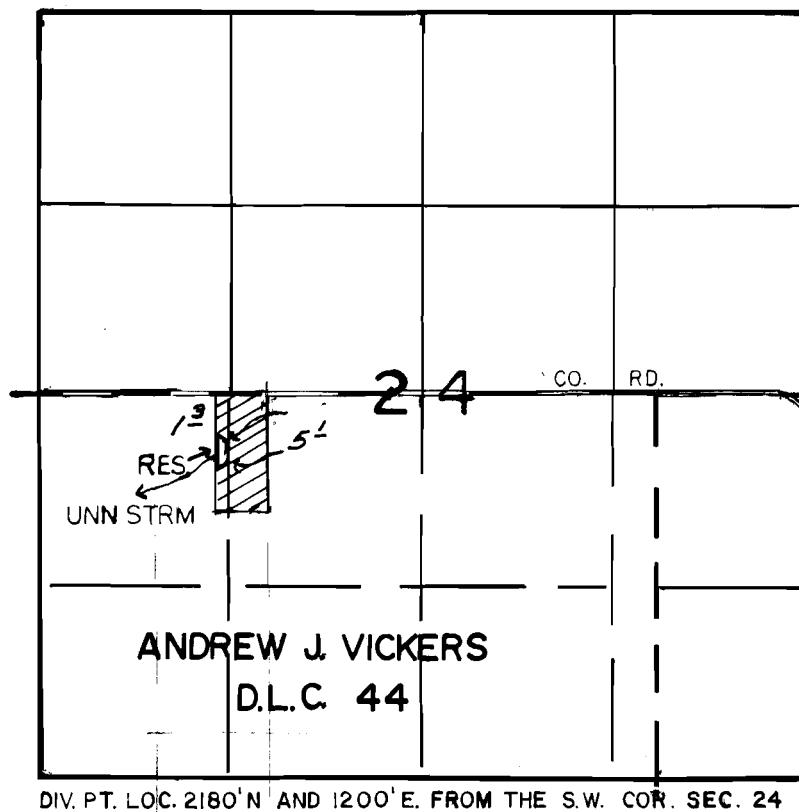

SCALE: 1"=1320'

FINAL PROOF SURVEY UNDER

R-62147 R-8289
Application No. ~~62148~~ Permit No. ~~45908~~...
IN NAME OF

THOMAS E. LILLIE

Surveyed JULY 24... 19.8.7., by J.M. WARREN.....