


T.10S., R.36E., W.M.



The location of the div. pts. are 630' N. & 840' W.,
and 850' S. & 430' W., all from SE cor. sec. 17.

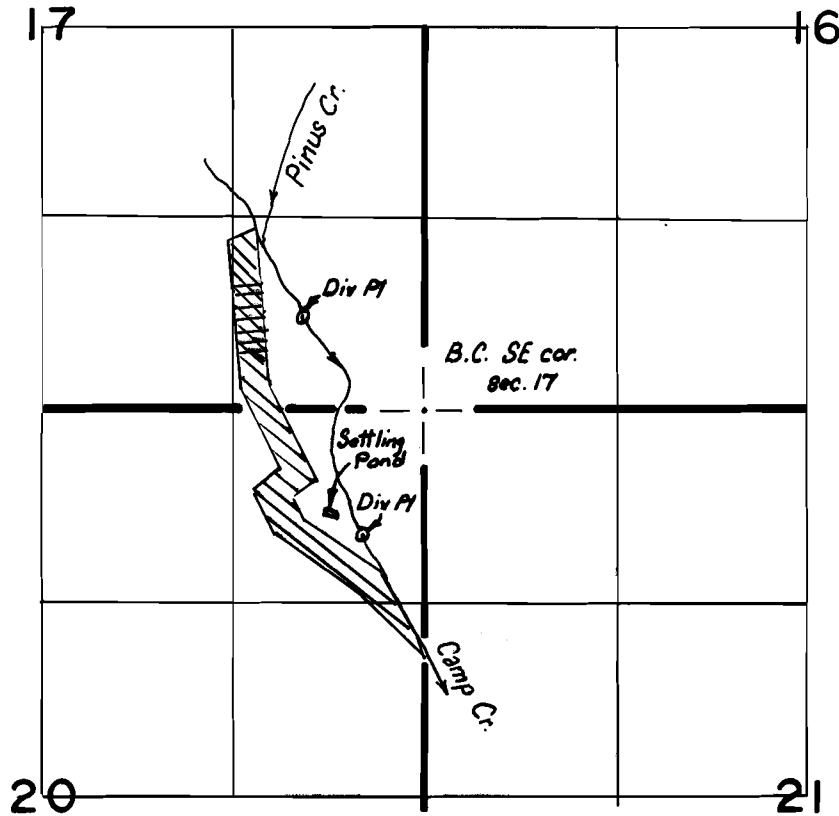

Scale: 1" = 1320'

FINAL PROOF SURVEY
UNDER

Application No. 62262. Permit No. 46413.....
IN NAME OF

.....PAUL MICEK.....

Surveyed 7-7-1988, by Kenn Kemp.....



Current mining



Future mining

P.T.S. KK