


T. 2S., R. 43E., W. M.

LOTS 3 & 4 SECTION 3

SCALE 1" = 400'

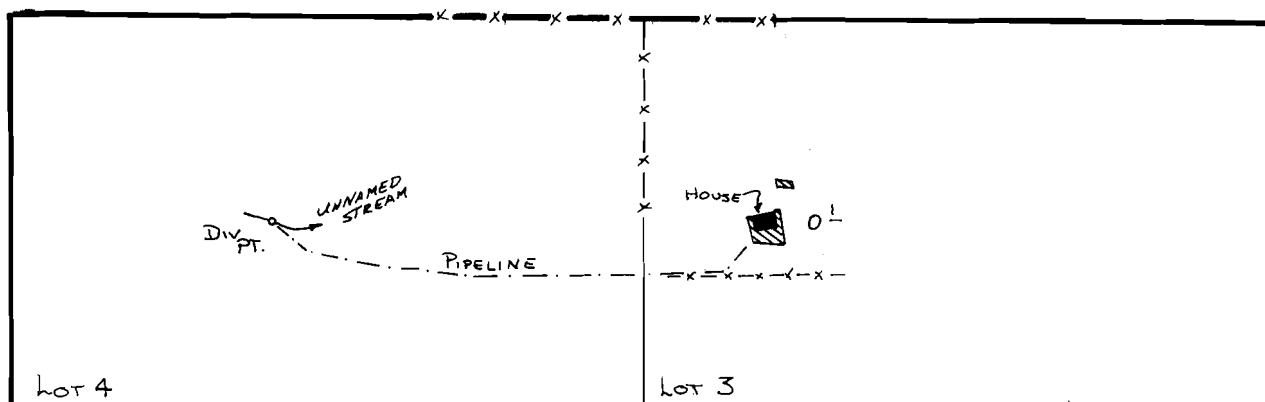

Div. Pt loc: 420' S & 770' W. FROM NE COR LOT 4 SEC 3

FINAL PROOF SURVEY UNDER

Application No. **62411** Permit No. **47215**
IN NAME OF

WILLIAM L. & GLADYS N. DAKES

Surveyed 8-17 1988, by V.L. Church