


T. 2 S. R. 4 E. W. M.

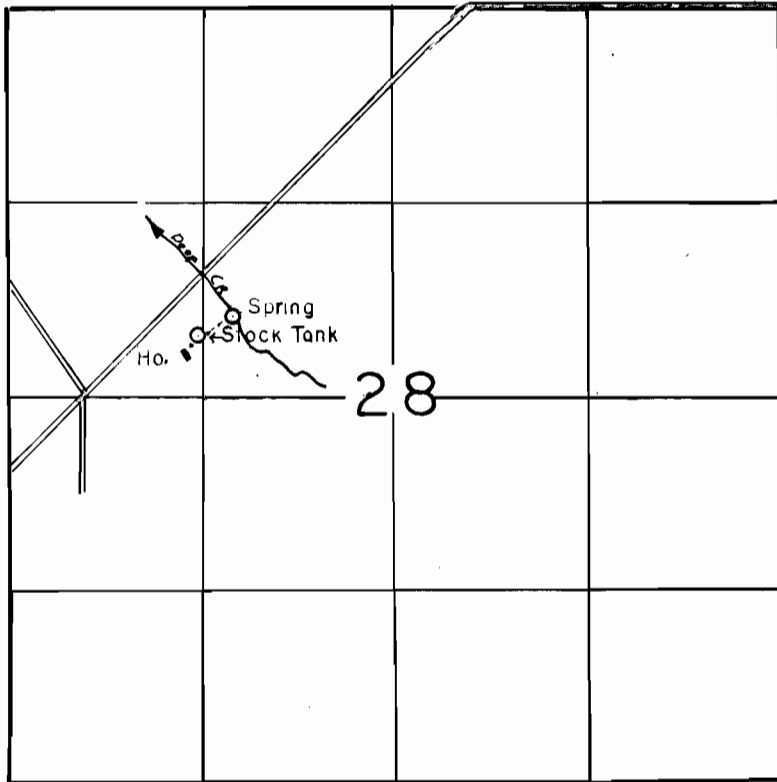

SPRING IS LOCATED 2150' S. AND 1550' E. FROM THE NW COR. SEC. 28

SCALE: 1" = 1320'

FINAL PROOF SURVEY
UNDER

Application No. 62441 Permit No. 47195

IN NAME OF

TODD, TODD, TODD & HOPPER

Surveyed AUG. 7, 1987, by T.M. WARREN