


Application No. ^{APPLICATION} # 63276
Permit No. 47272

1

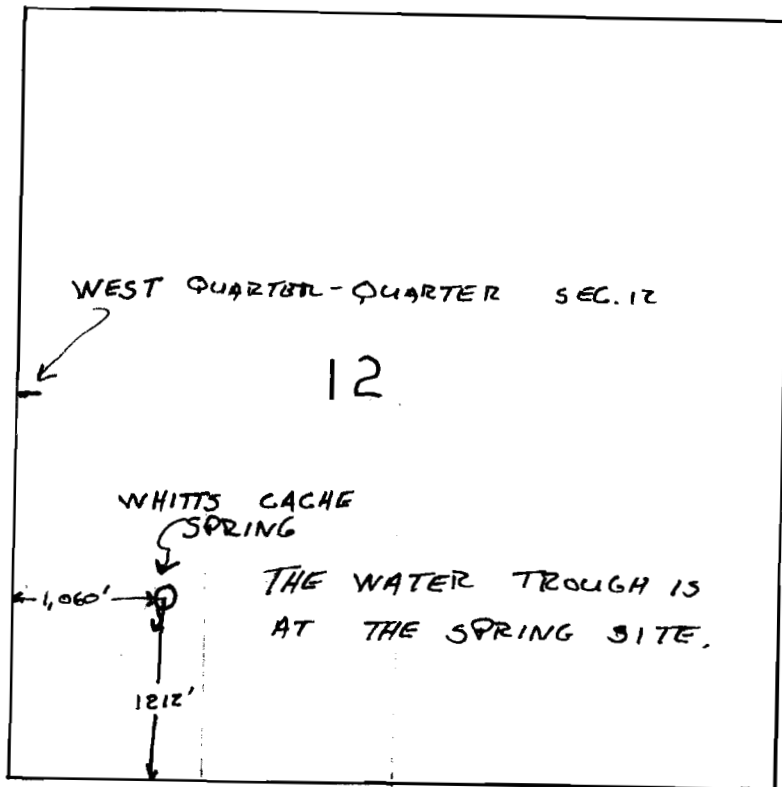

T40S R31E WBM

13

RECEIVED
NOV 15 1982
WATER RESOURCES DEPT.
SALEM, OREGON