




T. 28S., R. 11W., W.M.

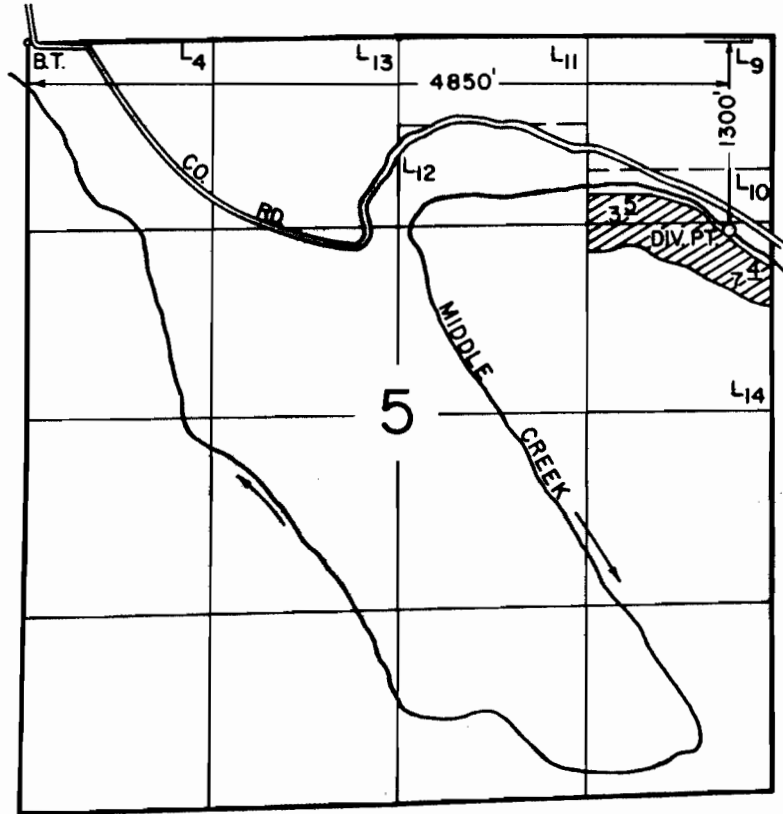

SCALE: 1" = 1320'

FINAL PROOF SURVEY
UNDER

- Application No. 63375. Permit No. 47358.....

IN NAME OF

.....COOS COUNTY SHERIFF.....

Surveyed SEPT. 20 1988, by B. S. JAMES.....