


T. 2 S. R. 3 E. W. M.

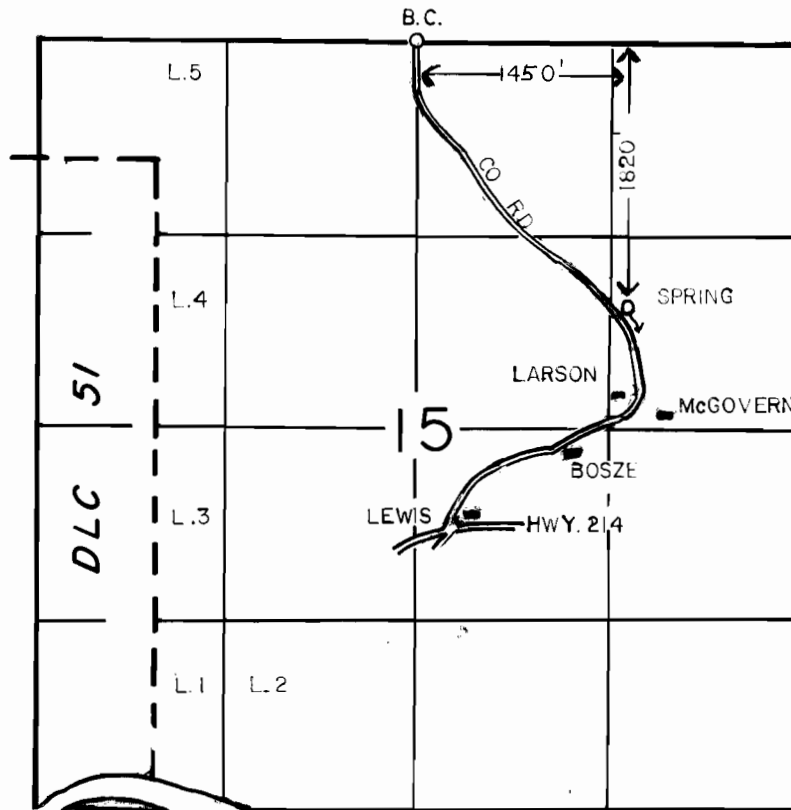

SCALE: 1" = 1320'

**FINAL PROOF SURVEY**  
UNDER

Application No. 63519... Permit No. 46825....  
IN NAME OF

McGOVERN, LARSON, BOSZE, LEWIS

Surveyed JULY 16... 1987., by I.M. WARREN.....