


T. 2S., R. 4E. W.M

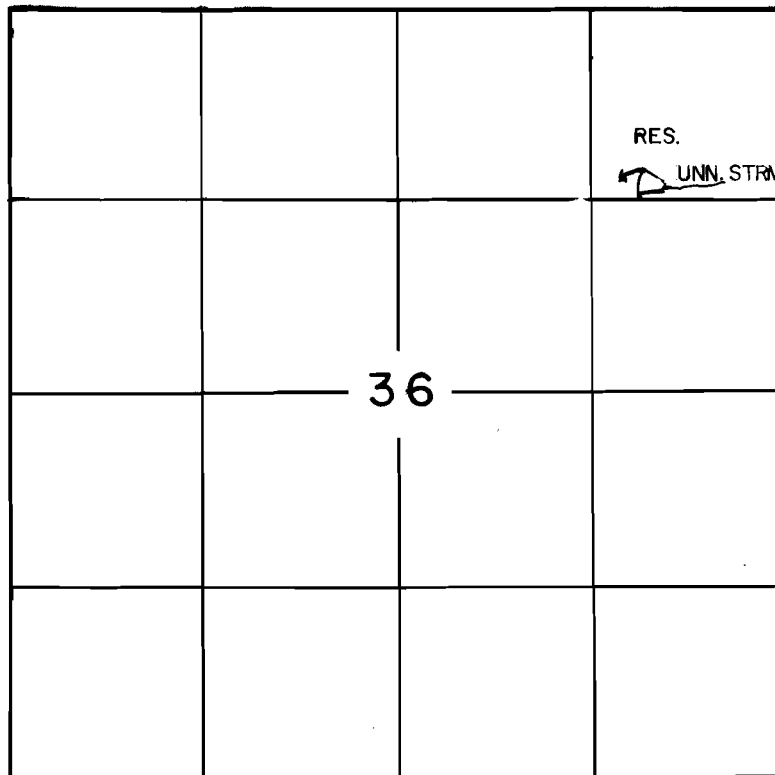

RES. LOCATED 1100'S. & 950 W. FROM THE N.E. COR. OF SEC. 36

SCALE: 1" = 1320'

FINAL PROOF SURVEY
UNDER

Application No. R-63704 Permit No. R-8497....
IN NAME OF

LOUIS W. WHITE

Surveyed AUG. 25... 1987.., by J.M. WARREN.....